

KANSAS


FORM 51 5M 6-46 PETROL

Ellis county

Section 3 Township 11 Range 18-W

Well No. #1, Warren Mortgage

Company Continental Oil Company

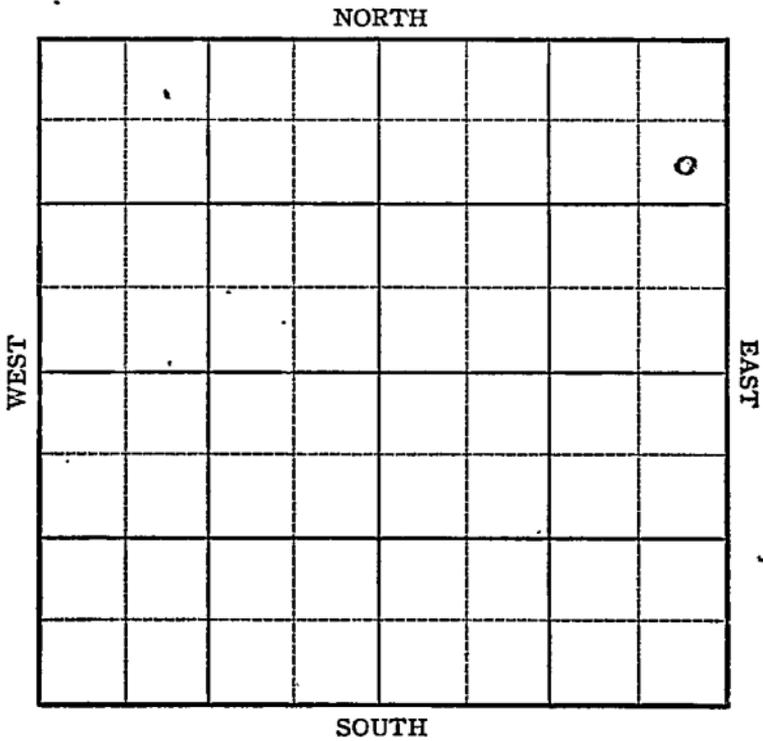

Sec. 3 Twp. 11 R. 18W

Well No. 1 Warren Mortgage Farm

Continental Company


Wildcat

990 Ft. from N. Line

Ft. from S. Line

330 Ft. from E. Line

Ft. from W. Line

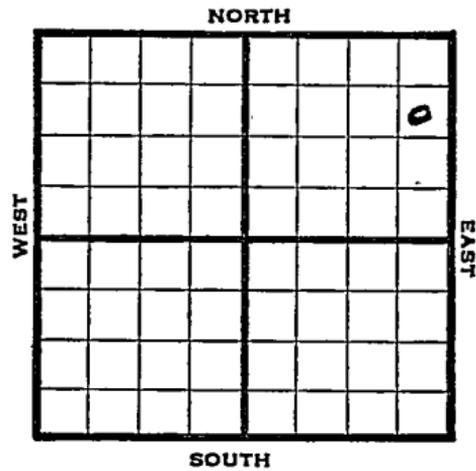

SE NE NE

1946	Elev. 2073	REPORT
11/27	Surface hole	
12/3	13" @ 240'	
	Anhy 1364'	
	Drlg 2775'	
12/10	1/2 Lans 3330'	
	BKC 3530'	
	Cong 3592	
	Arb 617-22 TD	
	Run 5"	
12/17	5" @ 3618'	
	2800' oil in 3 hrs	
1947		
1/4	TD 3625'	
	Swb 87 oil PH 3 hrs	
	32.5 gravity	
1/8	"	"
1/15	"	"
1/21	"	"
1/29	Arb 3617	
	5" @ 3618	
	Depth to pot 3000	
	TD 3625'	
	32.5 Gravity	

COMPLETED

Map No. 71 Sec. 3 Twp. 11 R. 18W

Well No. 1 Warren Mortgage

Continental Company

FIRST REPORT Contractor

SE NE NE


SECTION PLAT

990 Ft. from N. Line

_____ Ft. from S. Line

330 Ft. from E. Line

_____ Ft. from W. Line

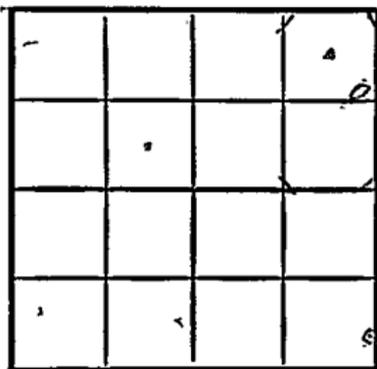

Ellis County

Location _____

Rig up _____

Drilling and Remarks:

surface hole

RECORD

Cased _____ in., _____ ft.

Sand _____

Gas _____

Oil _____

Total Depth _____

PRODUCTION

1st 24 hrs. Nat. _____

1st 24 hrs. after shot _____

Gas _____ Cu. Ft.

Dry Hole _____

Abandoned _____

Date

NOV 27 1946 19

S. J. LEWIS Scout

Map No. 71 Sec. 3 Twp. 11 R. 18W

Well No. 1 Warren Mortgage

Continental Company

COMPLETE

Contractor

SE NE NE

E12073

SECTION PLAT

990 Ft. from N. Line

_____ Ft. from S. Line

330 Ft. from E. Line

_____ Ft. from W. Line

			0

Ellis County

Location _____

Rig up _____

Drilling and Remarks:

Per 3617

5" @ 3618

Depth Per 3000

225 ft

RECORD

Cased _____ in, _____ ft.

Sand _____

Gas _____

Oil _____

Total Depth 3625

PRODUCTION

1st 24 hrs. Nat. _____

1st 24 hrs. after shot _____

Gas _____ Cu. Ft.

Dry Hole _____

Abandoned _____

Date

JAN 29 1947 19

S. L. LEWIS Scout