

KANSAS


FORM 51 IOM 12-46 PETROL

Ellis

Section 3 Township 11 Range 18-W

Well No. #2 Warren Mortgage

Company Continental

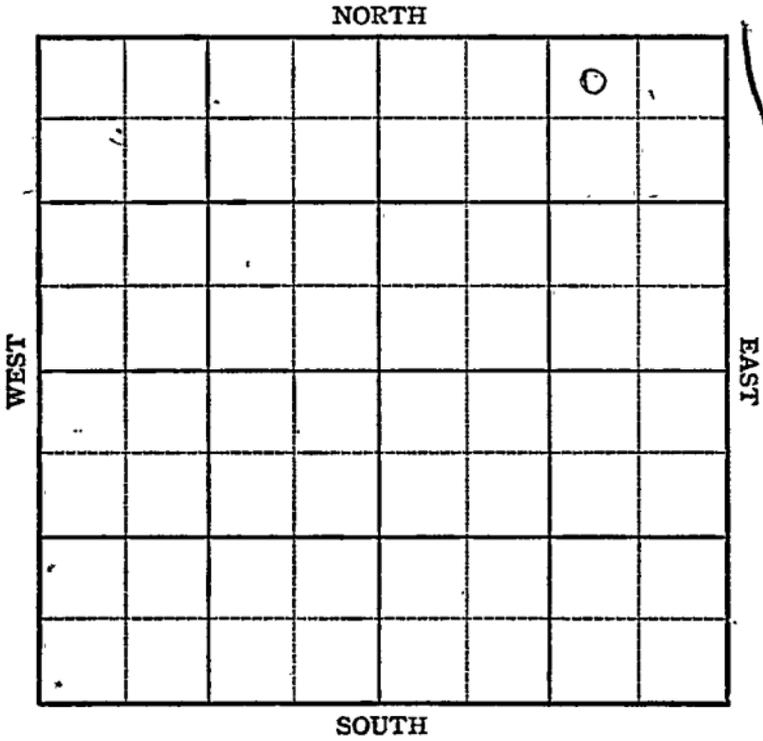



Sec. 3 Twp. 11 R. 18-W

Well No. #2 Warren Mortgage Farm

Continental Company


Burnett Pool

330 Ft. from N. Line

_____ Ft. from S. Line

990 Ft. from E. Line

_____ Ft. from W. Line

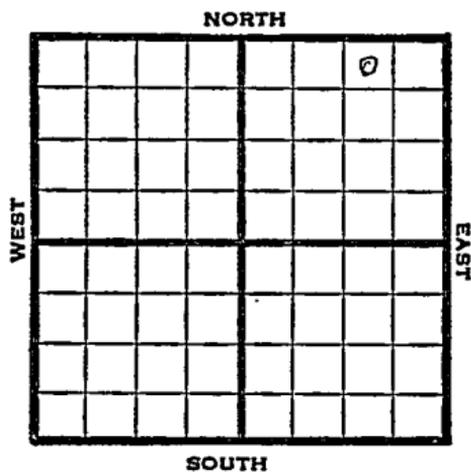

NW NE NE

1947 Elev. 2095 REPORT

2/19 Location

2/26 10" @ 240'
Drlg 875'

3/4 Drlg 3284

3/11 Arb 3643
6" @ 3644'
TD 3647'
Swb 475 bbls oil in 5 hrs

3/19 Arb 3643'
5" @ 3644
Depth Pot
3000
Grav. 27
TD 3647'

COMPLETED

Map No. 71 Sec. 3 Twp. 11 R. 18W

Well No. 2 Warren Mortgage

Continental Company

FIRST REPORT

Contractor


NW NE NE

330 Ft. from N. Line

_____ Ft. from S. Line

990 Ft. from E. Line

_____ Ft. from W. Line

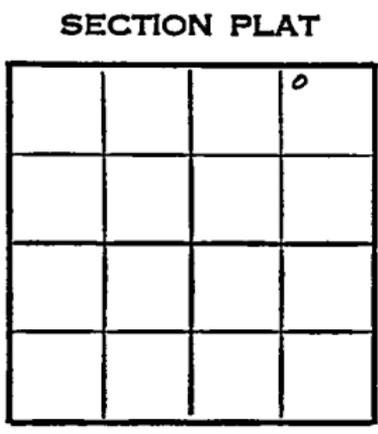

Ellis County

Location X

Rig up _____

Drilling and Remarks:

RECORD

Cased _____ in., _____ ft.

Sand _____

Gas _____

Oil _____

Total Depth _____

PRODUCTION

1st 24 hrs. Nat. _____

1st 24 hrs. after shot _____

Gas _____ Cu. Ft.

Dry Hole _____

Abandoned _____

Date

FEB 19 1947 19

S. I LEWIS Scout

Map No. 71 Sec. 3 Twp. 11 R. 18W

Well No. 2 Warren Mortgage

Continental Company
COMPLETE

Contractor

NW NE NE

E 12095
SECTION PLAT

330 Ft. from N. Line

_____ Ft. from S. Line

990 Ft. from E. Line

_____ Ft. from W. Line

			0

Ellis County

Location _____

Rig up _____

Drilling and Remarks:

Co # 3643
5" @ 3644
Dept # 364
3000

27 2/2

RECORD

Cased _____ in., _____ ft.

Sand _____

Gas _____

Oil _____

Total Depth 2647

PRODUCTION

1st 24 hrs. Nat. _____

1st 24 hrs. after shot _____

Gas _____ Cu. Ft.

Dry Hole _____

Abandoned _____

Date

MAR 1 9 1947 19

S. J. LEWIS Scout