


KANSAS - Ellis

FORM 51 IOM 12-46 PETROL

Section 3 Township 11 Range 19W

Well No. 3 Warren Mortgage

Company Continental

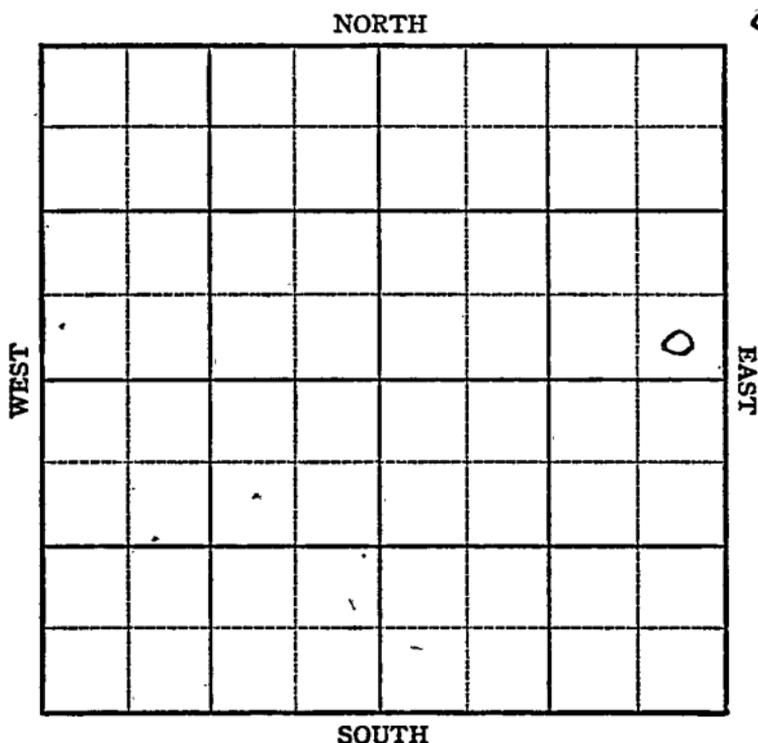

Sec. 3 Twp. 11 R. 18-W

Well No. #3 Warren Mortgage Farm


Continental Company  
Burnett

         Ft. from N. Line

330 Ft. from S. Line

330 Ft. from E. Line

         Ft. from W. Line

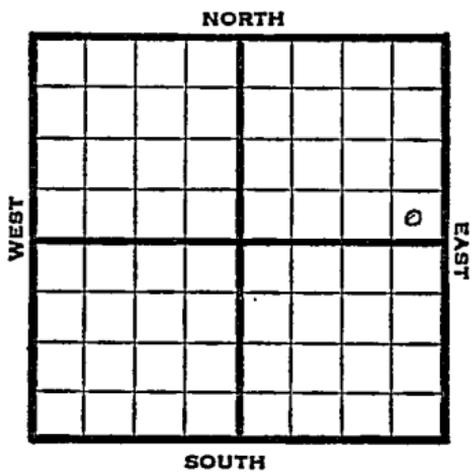

SE NE

1947 Elev. 2050' REPORT

5/14	Location
5/20	"
5/27	Derrick
6/3	"
6/10	"
6/21	"
6/24	"
7/1	"
7/8	"
7-16	RUR
7/22	10" @ 205' Drlg 2315'
7/29	Arbuckle 3592'-99' TD Run 5"
8/6	5" @ 3595' TD 3601' Swb 48 bbls oil PH 3 hrs.

OVER

1947

8/13

Arbuck13 3592'

5" @ 3595'

Echo Pot 3000

Gr. 32

T.D. 3601'

Completed

**COMPLETED**



Misc. Small Maps \_\_\_\_\_  
Cards                       
Tracing \_\_\_\_\_  
France Map \_\_\_\_\_  
Scarborough Map \_\_\_\_\_  
Pierce Map                       
Geological Dept. \_\_\_\_\_  
Pierce Plat Book \_\_\_\_\_

Map No. 71 Sec. 3 Twp. 11 R. 18W

Well No. 3 Warren Mortgage

Continental Company

COMPLETE

Contractor

SE NE

*F. 2000*  
SECTION PLAT

			o

         Ft. from N. Line

330 Ft. from S. Line

330 Ft. from E. Line

         Ft. from W. Line

Ellis County

Location                                 

Rig up                                 

Drilling and Remarks:

*Ce 43092*  
*5103595*  
*Ech 40024000*  
  
*02 2/2*

RECORD.

Cased          in.,          ft.

Sand                                 

Gas                                 

Oil                                 

Total Depth 3601

PRODUCTION

1st 24 hrs. Nat.                                 

1st 24 hrs. after shot                                 

Gas                                  Cu. Ft.

Dry Hole                                 

Abandoned                                 

Date

AUG 13 1947 19

S. J. LEWIS

Scout

*W. M. P.*

Misc. Small Maps	<i>ms</i>
Cards	<i>ms</i>
Tracing	<i>ms</i>
France Map	<i>ms</i>
Scarborough Map	<i>ms</i>
Pierce Map	<i>ms</i>
Geological Dept.	<i>ms</i>
Three First Books	<i>ms</i>