

Trego

KANSAS

SECTION 3 TOWNSHIP 11 RANGE 21W

WELL NO. #7 Hedstrom

COMPANY Theo. Gore

NORTH

WEST

EAST

SOUTH

							0

Trego

KANSAS

SEC. 3	TWP. 11	R. 21W
-----------	------------	-----------

WELL NO.

#7 Hedstrom

FARM

COMPANY

Theo. Gore

CONTRACTOR

Veeder

SW White


Ft. from N. Line

Ft. from S. Line

Ft. from E. Line

Ft. from W. Line

NE NE NE

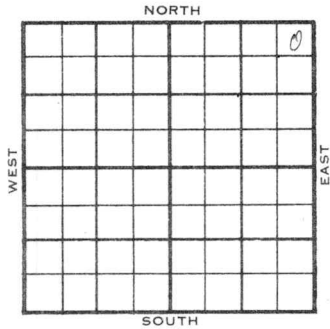

1956

ELEVATION

2079'

REPORT

4-11

Comm. 4-9-56

8" @ 208 w/135

WOC

5-9

DST 3415-32 op 1 hr. rec. 150' OCM&MCO
 / 650' clean oil / 120' SW, BHP 1100/
 5 $\frac{1}{2}$ " @ 3638

CO

DD 3643

FU 2500' oil, tstg.

P/ 454 BOPD, no/wtr.

Tp. 3094', H. 3304', Tr. 3321',

KC 3341', A. 3636',

TD 3638'

COMPLETED

County Trego Elev. 2079
 Sec. 3 Twp. 11 Rgs. 21W
 Company Theo. Gore
 Farm Name Hedstrom No. 7

TOPS	DEPTH	LOG	DATUM	Loc. in Sec.
Anh.				NE NE NE
TP.	3094			
H.	3364			
Tr.	3321			
Dg.				
Bl.				
L.				Geol.
K.C.	3341			Contr.
B.K.C.				Veeder
Ce.				Pool
C.				SW White
M.				
M.				
K.				
Mz.				
Me.				
V.				
S.				
S.				
A.	3636			
R.				
PE.				
G.				
TD.	3638			

Date Comm. 4-9-56 MAY 9 1956
8" @ 208/135 APR 18 '56 DST 3415
-32 1 hr sec 150' OCM & MCO
+ 650' chl. oil + 120' SW BHP
11001 # 3433 APR 25 '56 5 1/2 @ 3638
CO RD 3643 TP FU 2500' oil
tstg. MAY 2 '56 < MAY 9 '56 Ph P 454
Repd no/water