


KANSAS

Section 30 Township 11 Range 16W

Well No. 3 DeHoff

Company Skelly

Bemis Pool
NORTH

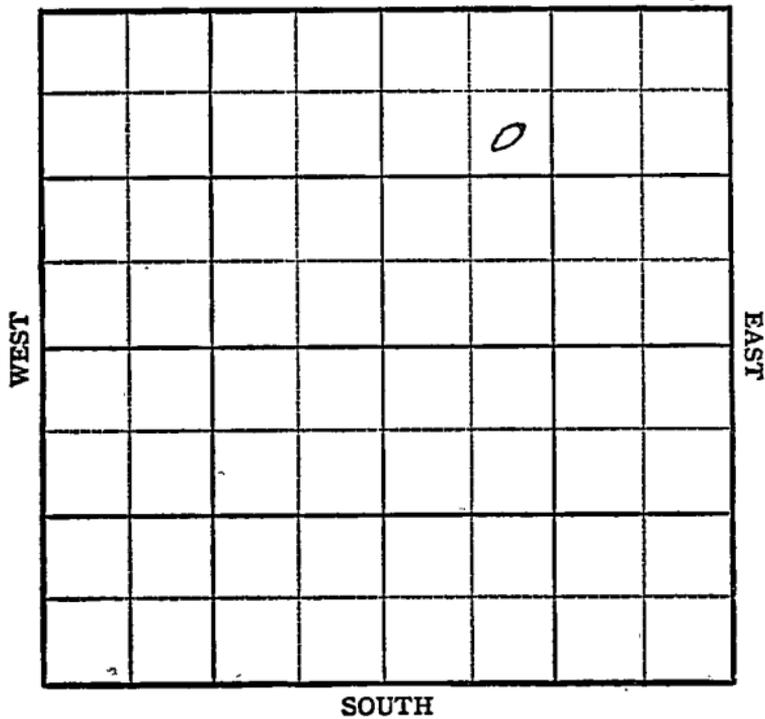

SOUTH

Sec. 30 Twp. 11 R. 16W ✓

Well No. #3 DeHoff Farm
Skelly Company

Bemis


990 Ft. from N. Line

_____ Ft. from S. Line

_____ Ft. from E. Line

990 Ft. from W. Line

SE NW NE

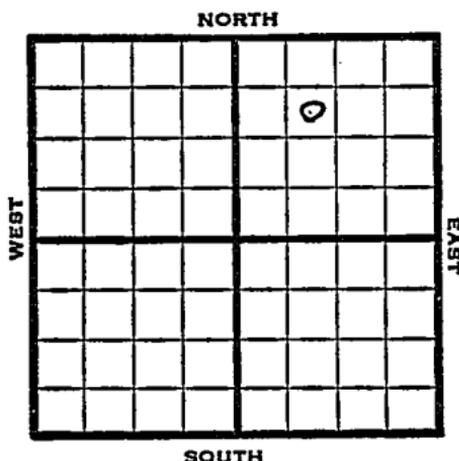

1948

ET: 1800'

REPORT

9/29

Surface hole

10/6

8" @ 999'

10/13

Drilg 2587'

10/19

Lansing 3003'

Arb. 3287-91'

TD 3291'

5 " @ 3288'

10/26

Simpson Sd 3276'

Arb. 3283'

5 " @ 3284'

TD 3307

Swb 80 bbls oil 6 hrs.

11/3

TD 3320'

500 acid swb 85 bbls oil - 4 hrs.

11/10

TD 3320'

Arb. 3283'

5" @ 3284'

2000 acid

Pump 175 Oil Pot

36° Gr.

Comp

COMPLETED

Map No. _____ Sec. 30 Twp. 11 R. 16W

Well No. 3 DeHoff

Skelly Company

FIRST REPORT

Contractor

SE NW NE

SECTION PLAT

		o	

990 Ft. from N. Line

_____ Ft. from S. Line

_____ Ft. from E. Line

990 Ft. from W. Line

Ellis County

RECORD

Location _____

Cased _____ in., _____ ft.

Rig up _____

Sand _____

Drilling and Remarks:

Gas _____

Oil _____

surface hole

Total Depth _____

PRODUCTION

1st 24 hrs. Nat. _____

1st 24 hrs. after shot _____

Gas _____ Cu. Ft.

Dry Hole _____

Abandoned _____

Date

SEP 29 1946 19

S. J. LEWIS Scout

