

Well No. 4 DeHoff

Company Skelly

Bemis Pool
NORTH

A 10x10 grid with the following labels:

- Left side: WEST
- Right side: EAST
- Bottom: SOUTH

A small '0' is located in the top-right cell of the grid.

KANSAS

Ellis County

Sec. 30 Twp. 11 R. 16W

Well No. #4 DeHoff Farm

Skelly Company

Bemis Pool


330' Ft. from N. Line

 Ft. from S. Line

990' Ft. from E. Line

 Ft. from W. Line

NW NE NE

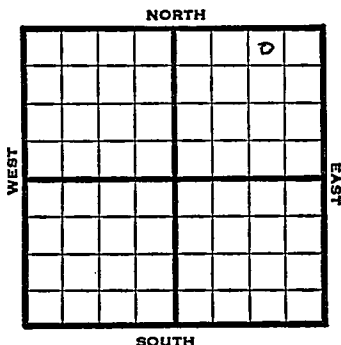

1948 Elev 1882' REPORT

10/20 RUR

10/26 8" @ 985'
Drlg 2180'

11/3 Lansing 3009'
Arbuckle 3316'
TD 3322'
5" @ 3317'

11/10 750 acid

11/16 TD 3333'
700 acid swb 1 bbl oil & 1½ W PH

11/23 "

11/30 "

12/8 "

12/15 "

12/22 "

12/29 "

1949

1/12 TD 3333'
Arb 3316'
5" @ 3317'
1450' acid
Pump 54 oil / 40% W Pot
36° Gr.
Comp

COMPLETED

Map No. _____ Sec. 30 Twp. 11 R. 16W

Well No. 4 DeHoff

Skelly

Company

FIRST REPORT

Contractor

NW NE NE


SECTION PLAT

330 Ft. from N. Line

_____ Ft. from S. Line

990 Ft. from E. Line

_____ Ft. from W. Line

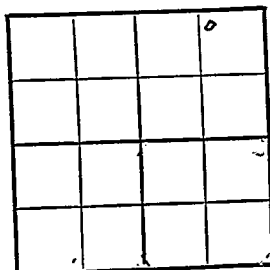

Ellis County

Location _____

Rig up _____

Drilling and Remarks:

R U R

RECORD

Cased _____ in., _____ ft.

Sand _____

Gas _____

Oil _____

Total Depth _____

PRODUCTION

1st 24 hrs. Nat. _____

1st 24 hrs. after shot _____

Gas _____ Cu. Ft.

Dry Hole _____

Abandoned _____

Date

OCT 20 1948 19

S. J. LEWIS

Scout

Kansas

Map No. 71 Sec. 30 Twp. 11 R. 16WWell No. 4 DeHoff


Skelly

Company

COMPLETE

Contractor

NW NE NE

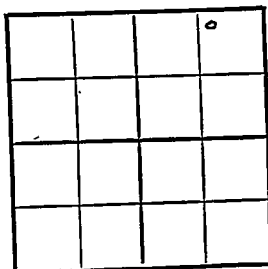E. 11992
SECTION PLAT330 Ft. from N. Line Ft. from S. Line990 Ft. from E. Line Ft. from W. Line

Ellis County

Location Rig up

Drilling and Remarks:

RECORD

Cased in., ft.Sand Gas Oil Total Depth 3238

PRODUCTION

1st 24 hrs. Nat. 1st 24 hrs. after shot Gas Cu. Ft.Dry Hole Abandoned

Date

JAN 12 1949

19

S. J. LEWIS

Scout

Q 3316
5" 3317
1450.0000
Prin 54 oil + 40%
Pat
36-2

O.W.W.O.

FORM 513 SUNRAY

County Ellis Elev. 1782
 Sec. 30 Twp. 11 Rge. 16W
 Company Skelly Oil Co.
 Farm Name L. DeHoff No. 4

TOPS	DEPTH	LOG	DATUM	Loc. in Sec.
Anh.				NW NE NE
Tr.				O.W.W.O.
Dg.				
BL.				
L.		3004		Geol.
K.C.				Contr.
B.K.C.				
Ce.		3286		
C.				Pool
M.				Bemis-Shuttles
M.				
K.				
Mz.				
Mo.				
V.		3302		COMPLETE
S.		3316		FIRST REPORT
A.				
R.				
Pe.				
G.				
T.D.		3333		

Date Comm.

Old Inf. 5" @ 3317, 54 BOPD / 40% wtr.

New Inf. PB 3300, Perf 60/3283-90, 250A / Sandoilfrac, no shows. sq all perfs, PB

3200, Perf 54/3182-88, 3000A, Swb 30 BO / 9 BW 21 hrs, PB 3174, Perf 54/3162-68, 2500A

Swb 5 BO / 3 BAW 8 hrs, PB 3118, Perf 16/3082-86 & 20/3091-95m 1000A, Swb 8 BO & 32 BW

7 hrs, PB 3040, perf 45/3020-25, 1000A, Swb 8 Bail 5 GWPH, DP3196, P30BO/15 BWPD COMPLETE