

Sec. 30 Twp. 11 R. 16W

Well No. #6 DeHoff Farm

Cities Service Company


Bemis

330 Ft. from N. Line

_____ Ft. from S. Line

330 Ft. from E. Line

_____ Ft. from W. Line

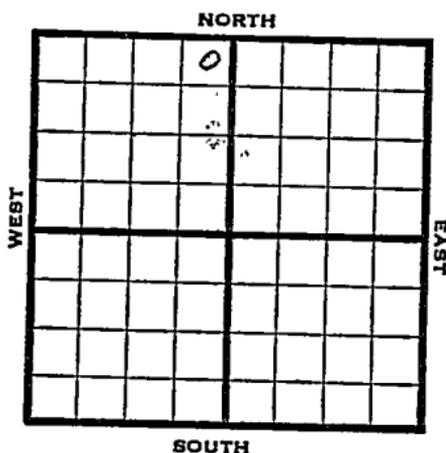

NE NW

1948 Elev. 1809' REPORT

- 4/7 Location
- 4/14 8" @ 335'
Drlg. 1260'
- 4/21 Drlg. 3185'
- 4/28 Dodge 2982'
Lansing 3008'
Arbuckle 3291'-93'
TD 3293'
5" @ 32928
RUST
- 5/5 TD 3305'
1000 acid.
- 5/12 TD 3314'
Pump 67 bbls oil
- 5/19 - 3324 - 1500 acid
Pump 56 hbls oil & 2 W in 24 hrs.
TD 3329'
- 5/26 Arbuckle 3291'
5" @ 3292'
4000 Acid
Pump 67 Pot
Gr. 38°
TD 3329'

COMPLETED

Map No. _____ Sec. 30 Twp. 11 R. 16W

Well No. 6 DeHoff

Cities Service _____ Company

FIRST REPORT _____ Contractor

NE NW

SECTION PLAT

330 Ft. from N. Line

_____ Ft. from S. Line

330 Ft. from E. Line

_____ Ft. from W. Line

	a		

Ellis County

Location X

Rig up _____

Drilling and Remarks:

RECORD

Cased _____ in., _____ ft.

Sand _____

Gas _____

Oil _____

Total Depth _____

PRODUCTION

1st 24 hrs. Nat. _____

1st 24 hrs. after shot _____

Gas _____ Cu. Ft.

Dry Hole _____

Abandoned _____

Date

APR 7 1948

19

S. J. LEWIS Scout

Map No. 71 Sec. 30 Twp. 11 R. 16W

Well No. 6 DeHoff

Cities Service Company

COMPLETE

Contractor

NE NW

E. I. 1809
SECTION PLAT

330 Ft. from N. Line

 Ft. from S. Line

330 Ft. from E. Line

 Ft. from W. Line

	0		

Ellis County

Location

Rig up

Drilling and Remarks:

CR 80291

5" 03292

4000ccial

Pump 67 Pst

38° Gr

RECORD

Cased in., ft.

Sand

Gas

Oil

Total Depth 0329

PRODUCTION

1st 24 hrs. Nat.

1st 24 hrs. after shot

Gas Cu. Ft.

Dry Hole

Abandoned

Date

MAY 26 1948

19

S. J. LEWIS

Scout