


SECTION 30 TOWNSHIP 11S RANGE 16W

WELL NO. #1 DeHoff

COMPANY Tenn. Gas Trans.

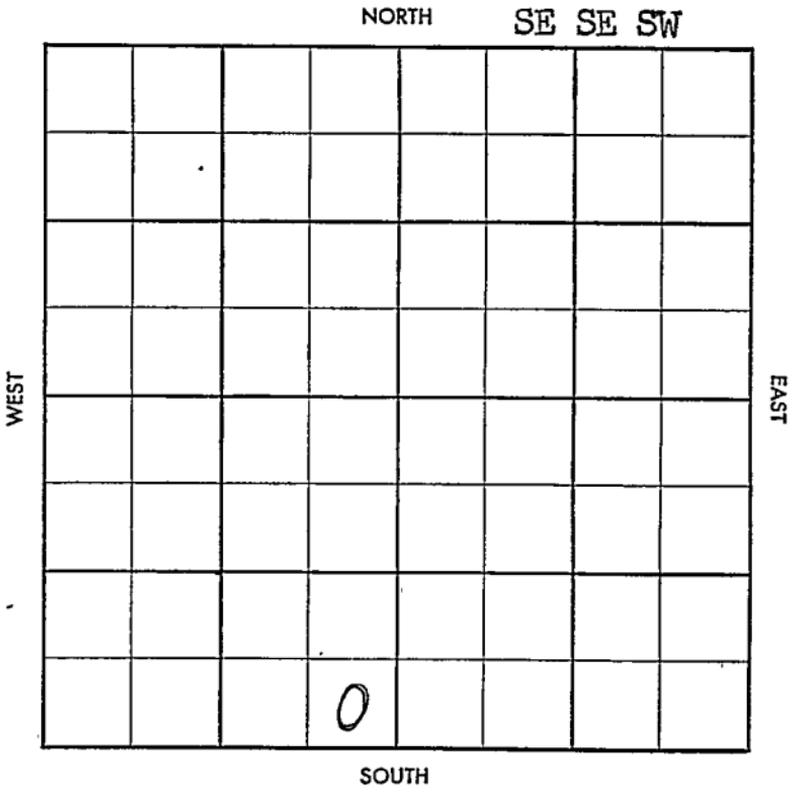

CO. ~~Elvis~~ ELEV. ¹⁸⁷⁰ 1871 ~~DF~~
SEC. ~~30~~ TWP. 11 RGE. 16
COMPANY ~~Tenn. Gas. Trans. 1~~

ABANDONED
DEC 18 '57

FARM De Hoff C.S.C. - FC
LOC. SE SE SW

GEOL. _____
CONTR. Peol Bros tools
POOL Wildcat
SPUD 12/2/57
8" 203 w/150, Drl. :
Flug. E. " A 1050
Hb 3044 TR
3069 Lsg 3090
DST 3125-95
60" 39' USOCM

NO. SEC. TWP. RGE.

FPO BHP 737/20" Ø 3237
OFC 11 " 50 TOPS H 3044 TR 3069
Lsg 3090^{12/2} BKC 3312^{11/15} SHC 3350-4251
DST 3350-90 30" 30' M BHP
300/20" Chry C 3362^{11/95} Wheelers
art 3404^{12/35} DST 3408-13 30"
12' M BHP 1295/40" Sold at
3418 RTD 3480 LTD 3479
-1547
D & A