

Ellis

Map No. 71 Sec. 30 Twp. 11 R. 16WWell No. 1 De Hoff

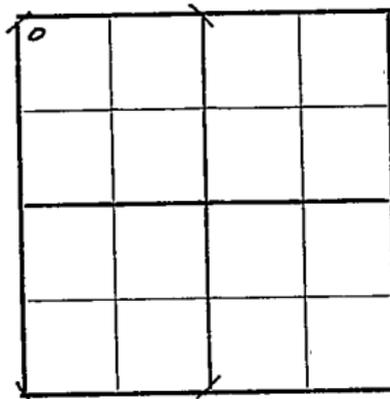
Cities Service Oil Company

FIRST REPORT

Contractor

NW/C

SECTION PLAT

330 Ft. from N. Line

_____ Ft. from S. Line

_____ Ft. from E. Line

330 Ft. from W. Line

SEMI-WILDCAT

RECORD

Location _____

Cased _____ in., _____ ft.

Rig up _____

Sand _____

Drilling and Remarks:

Gas _____

Oil _____

Total Depth _____

Derrick

PRODUCTION

1st 24 hrs. Nat. _____

1st 24 hrs. after shot _____

Gas _____ Cu. Ft.

Dry Hole _____

Abandoned _____

Date

APR 29 1942 19

S. J. LEWIS Scout

Ellis

KANSAS

Map No. 71 Sec. 30 Twp. 11 R. 16WWell No. 1 De HoffCities Service Oil Company**COMPLETED**

Contractor

Nw/C

SECTION PLAT

0			

330 Ft. from N. Line

_____ Ft. from S. Line

_____ Ft. from E. Line

330 Ft. from W. Line

SEMI WILDCAT

RECORD

Location _____

Cased _____ in., _____ ft.

Rig up _____

Sand _____

Drilling and Remarks:

Gas _____

Oil _____

Total Depth 3368Oil & 33335" @ 33342500 acidEcld P & 2991

PRODUCTION

1st 24 hrs. Nat. _____

1st 24 hrs. after shot _____

Gas _____ Cu. Ft.

Dry Hole _____

Abandoned _____

346 Gr

Date

MAY 27 1942 19S. J. LEWIS Scout

Please check location. First report shows Section 30.

Paul.

Misc. Small Maps	<i>RM</i>
Cards	<i>RM</i>
Tracing	<i>RM</i>
France Map	<i>RM</i>
Scarborough Map	<i>RM</i>
Moody Map	<i>RM</i>
Geological Dept.	
Moody Plat Book	