

KANSAS

FORM 51 5M 4-41 PETROL

Ellis


Section 30 Township 11 Range 16-W

Well No. #2 DeHoff

Company Cities Service Oil

Bemis Pool

NORTH

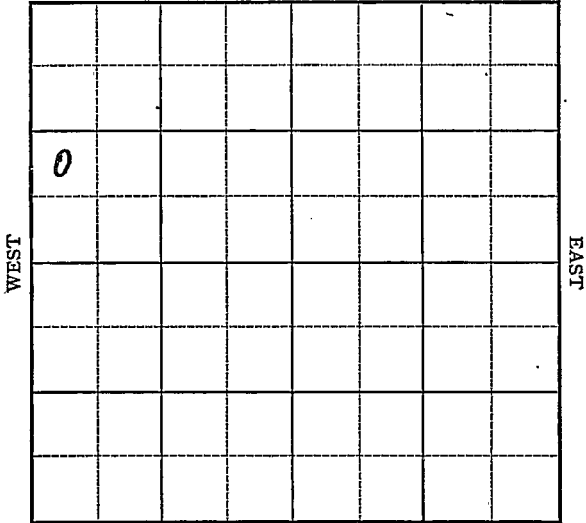

SOUTH

Sec. 30 Twp. 11 R. 16-W

Well No. #2 DeHoff Farm

Cities Service Oil Company

(Bemis)


_____ Ft. from N. Line

990 Ft. from S. Line

_____ Ft. from E. Line

330 Ft. from W. Line

Elev. 1870

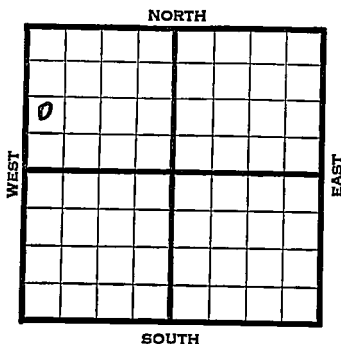

1942	REPORT
5/27	Location
6/3	"
6/10	8" - 1062' Drlg. 1860'
6/17	Drlg. 3160'
6/24	Lans. 3076' Simp. 3351'
	Arb. 3363-65' T.D. 5" - 3363' RUST.
7/1	T.D. 3376' 1900' oil 9 hours.
	2000 acid.
7/8	Arb. 3363'
	5" - 3363'
	2000 acid.
	T.D. 3373'
	Echometer potential 1768 bbls.
	3l. Gravity
	COMPLETED

KANSAS

Ellis

Map No. 71 Sec. 30 Twp. 11 R. 16W

Well No. 2 DeHoff

Cities Service Oil Company

FIRST REPORT

Contractor

NW SW NW

SECTION PLAT

o			

_____ Ft. from N. Line

990 Ft. from S. Line

_____ Ft. from E. Line

330 Ft. from W. Line

BEMIS POOL

Location XX

Rig up _____

Drilling and Remarks:

RECORD

Cased _____ in., _____ ft.

Sand _____

Gas _____

Oil _____

Total Depth _____

PRODUCTION

1st 24 hrs. Nat. _____

1st 24 hrs. after shot _____

Gas _____ Cu. Ft.

Dry Hole _____

Abandoned _____

Date

MAY 27 1942

S. I. LEWIS Scout

Ellis

KANSAS

Map No. 71 Sec. 30 Twp. 11 R. 16WWell No. 2 DeHoffCities Service Oil Company**COMPLETED**

Contractor

NW SW NW

_____ Ft. from N. Line

990 Ft. from S. Line

_____ Ft. from E. Line

330 Ft. from W. Line

SECTION PLAT

0			

BEMIS POOL

Location _____

Rig up _____

Drilling and Remarks:

Cr 33635" @ 33632000 acidEchd 2817653/2/42

RECORD

Cased _____ in., _____ ft.

Sand _____

Gas _____

Oil _____

Total Depth 3373

PRODUCTION

1st 24 hrs. Nat. _____

1st 24 hrs. after shot _____

Gas _____ Cu. Ft.

Dry Hole _____

Abandoned _____

Date

JUL 8 1942 19S. J. LEWIS Scout