

KANSAS


Ellis

FORM 51 5M PETROL

Section 30 Township 11 Range 16W

Well No. 5 Dehoff

Company Cities Service Oil

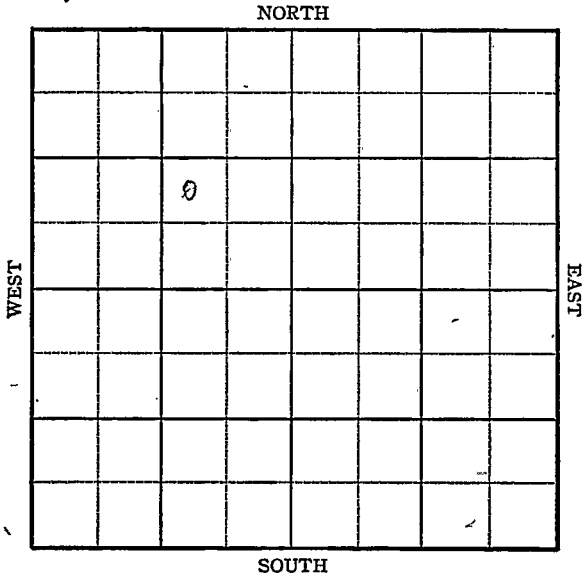

Sec. 30 Twp. 11 R. 16-W

Well No. #5 Dehoff Farm _____


Cities Service Oil Company

_____ Ft. from N. Line

990 Ft. from S. Line

990 Ft. from E. Line

_____ Ft. from W. Line

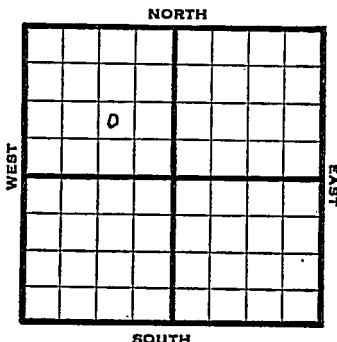

NW SE NW Elev. 1826

1945

REPORT

9/19 Location

9/28 8" @ 1005' WOC

10/3 Drig. 2580'

10/10 Lans 3030

Arb. 3340

TD 3344 Sat.

5" @ 3341 RUST

10/17 " " "

10/24 TD 3362

1000 acid.

Pump 27 fluid in 16 hrs. 35% wtr.

10/31 TD 3378

1000 acid.

Pump 244 fluid 24 hrs. 70% Wtr.

11/5 Arb. 3340

5" @ 3341

2000 acid.

TD 3378'

Pump 58 oil plus 116 W. Pot.

Grav. 31.0

COMPLETED

KANSAS

Pool Name Bemis

Map No. 71 Sec. 30 Twp. 11 R. 16W

Well No. 5 Dehoff

Cities Service Oil Company

FIRST REPORT

Contractor

NW SE NW

SECTION PLAT

	0		

_____ Ft. from N. Line

990 _____ Ft. from S. Line

990 _____ Ft. from E. Line

_____ Ft. from W. Line

Ellis County

Location X

Rig up _____

Drilling and Remarks:

RECORD

Cased _____ in., _____ ft.

Sand _____

Gas _____

Oil _____

Total Depth _____

PRODUCTION

1st 24 hrs. Nat. _____

1st 24 hrs. after shot _____

Gas _____ Cu. Ft.

Dry Hole _____

Abandoned _____

Date

SEP 19 1945 19

S. J. LEWIS Scout

KANSAS Pool Name Bemis
 Map No. 71 Sec. 30 Twp. 11 R. 16W

Well No. 5 DeHoff

Cities Service Oil Company

COMPLETED

Contractor

NW SE NW

 E 1/1926
 SECTION PLAT

_____ Ft. from N. Line

990 _____ Ft. from S. Line

990 _____ Ft. from E. Line

_____ Ft. from W. Line

	Δ		

Ellis County

RECORD

Location _____

Cased _____ in., _____ ft.

Rig up _____

Sand _____

Drilling and Remarks:

Gas _____

Oil _____

Total Depth 2378

PRODUCTION

1st 24 hrs. Nat. _____

1st 24 hrs. after shot _____

Gas _____ Cu. Ft.

Dry Hole _____

Abandoned _____

Per 43340
5" @ 3341
2000 acid
Pump 58 oil + 116 W
Est.
312 lb

Date

NOV 7 1945 19

S. J. LEWIS

Scout