


Section 30 Township 11 Range 16 W

Well No. # 6 DeHoff

Company Skelly Oil

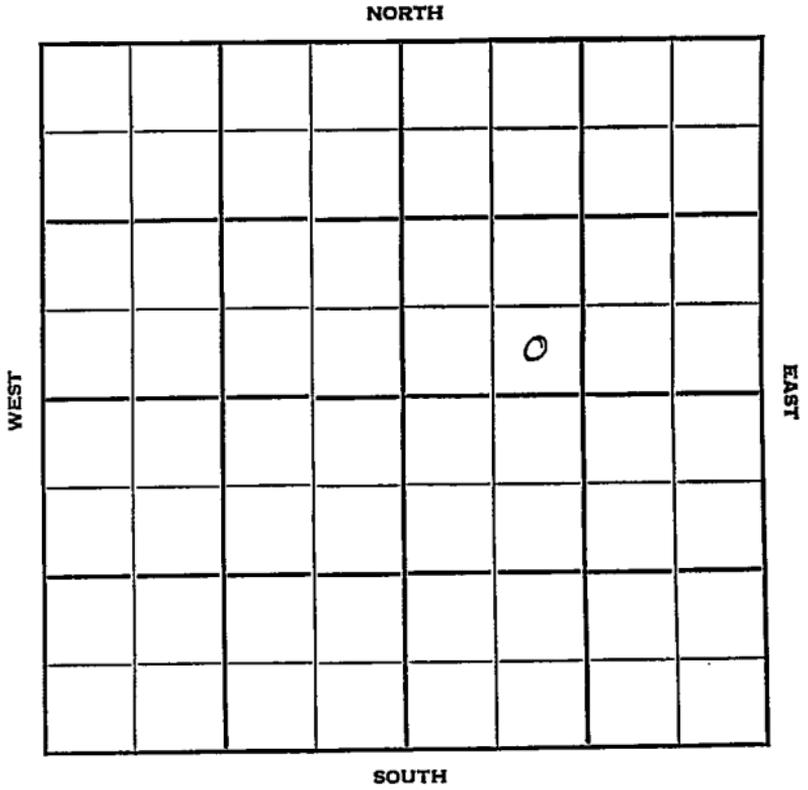

Sec. 30 Twp. 11 R. 16 W

Well No. # 6 DeHoff Farm

Skelly Oil Company

Contractor

Bemis Pool


Ft. from N. Line

330 Ft. from S. Line

Ft. from E. Line

990 Ft. from W. Line

SE SW NE

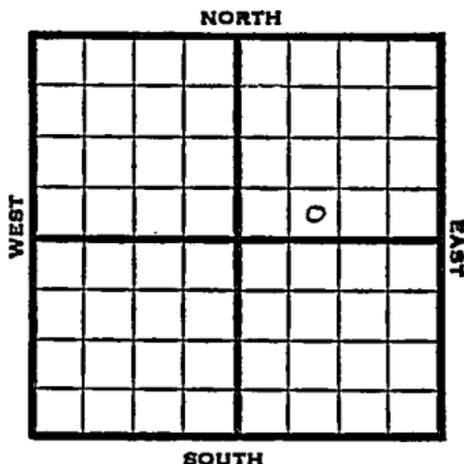

1951

Elev. 1840' REPORT

5/2

Location

7/11

Spud 5-12-51  
 SWD Well TD 3518  
 Anhy 1045 8" @ 1055  
 Heeb. 3008 Tor. 3031  
 Lans. 3055 Cong. 3334  
 Arb. 3372 TD 3428  
 5" @ 3373 DD 3518  
 Ran 94' 4" liner 3000 A  
 Comp. for SWD well

**ABANDONED**




County Ellis State Kansas

Sec. 30 (Blk. 11) (Sur. 16W) (Twp.) (Rge.) Map No.

Operator Skelly Oil

Well No. 6 Farm DeHoff

Elev. 1840 Location SE SW NE

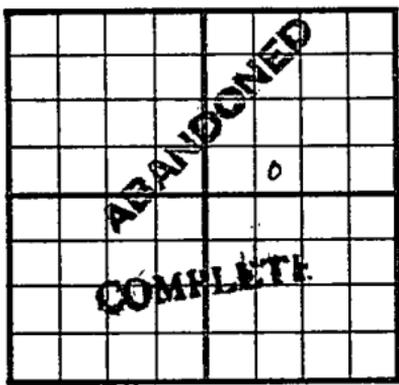

330 Ft. From S Line NE

990 Ft. From W Line Quarter

1st. Report

Completion JUL 11 1951

Remarks Bemis Pool

Spudding Date 5-12-51

Drig. Data SWD well TD 3518

Anhy 1045 8" @ 1055 Heeb. 3008

Tor. 3031 Lans. 3055 Cong. 3334

Arb. 3372 TD 3428 5" @ 3373

DD 3518 Ran 94' 4" liner 3000 A

Comp. for SWD well

J. E. TYRA