


Ellis

KANSAS

SECTION 30 TOWNSHIP 11S RANGE 18W

WELL NO. #2 McNeley

COMPANY Woodman-Iannitti

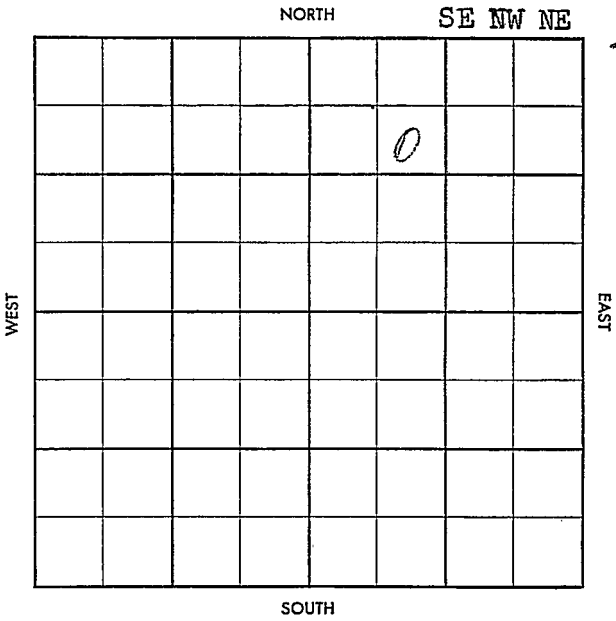

6

CO. Elk ELEV. _____
SEC. 30 TWP. 11 RGE. 18W
COMPANY Woodman-Iannitti No. 2

JAN	8	'58	o
FIRST REPORT			

FARM McNeley
LOC. SE NW NE

GEOL. _____
CONTR. Co. Tools
POOL Riverview
SPUD 1/6/58
8" @ 196 w/150 WOC

CO.
LSE.
NO.
SEC.
TWP.
RGE.

CO. Ellis ELEV. 2078 FEB 19 '58
 SEC. 30 TWP. 11 RGE. 18W
 COMPANY Woodman-Iannitto 2 COMPLETE

FARM McNeley
 LOC. SE NW NE

An 1382
H 32390
TR 3303
L 3329
C 3573
S 3588
A 3615
TD 3621

GEOL. _____
 CONTR. Co. Tools _____
 POOL Riverview
 SPUD 1/6/58
8" @ 196 w/150 WOC
 JAN 15 '58 3420
 JAN 22 '58 DST
3616-21 60"
155' free oil
60' w BH P440

55 5 1/2 3616/125 wnet
 JAN 29 '58 FEB 5 '58 no log CO 3621
FU 1475' Pld 3090 w b
2 BOPh 3090 w 10 hrs Nat
 POP FEB 12 '58 FEB 19 '58 P50 Popd
+ 1090 w. nat

253092

CO
LSE
NO.
SEC
TWP.
RGE.