

KANSAS


Ellis

FORM 51 5M 1-42 PETROL

Section 30 Township 11 Range 18-W

Well No. #1 T. W. McNeley

Company Stanolind

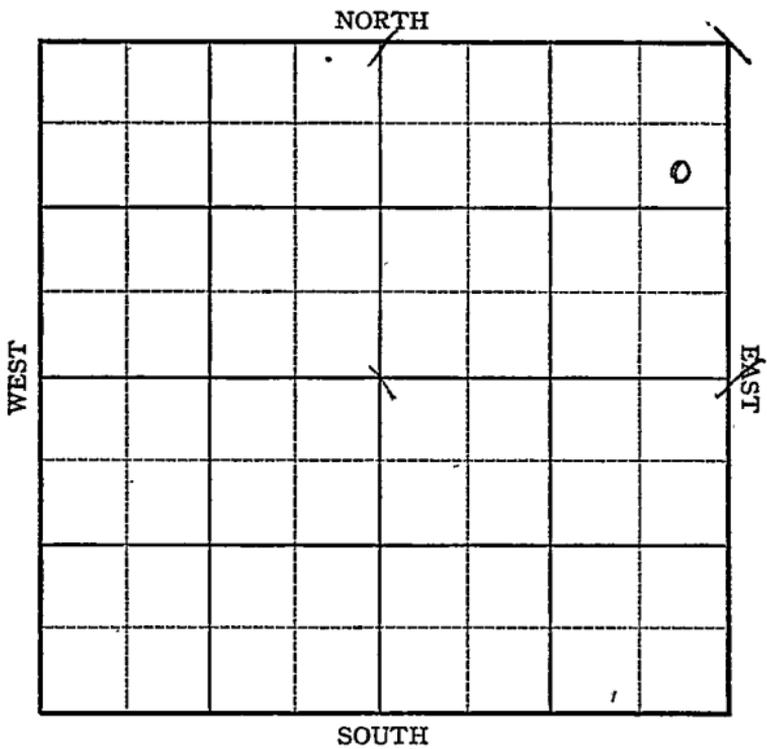

**KANSAS**

Ellis

Sec. 30 Twp. 11 R. 18-W

Well No. #1 T. W. McNeley Farm

Stanolind Company

Riverview


990 Ft. from N. Line

\_\_\_\_\_ Ft. from S. Line

330 Ft. from E. Line

\_\_\_\_\_ Ft. from W. Line

*Elev. 2081*

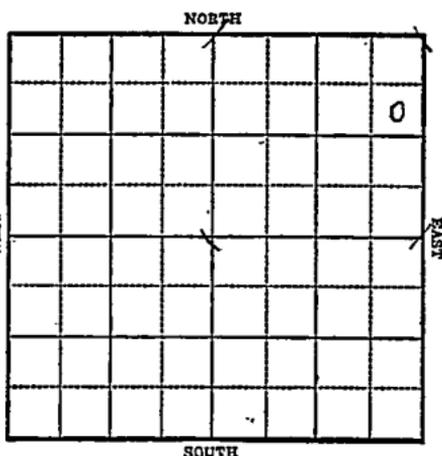

1943

R E P O R T

7/14 Location.

7/21 "

7/28 Derrick

8/4 Rotary

8/11 8" @ 214'  
Anhy 1390  
Drlg. 2265'

8/18 Lans 3317  
SSO 3356-61  
Coring 3367 SO

9/25 BKC 3536  
Simp 3583  
Arb 3606  
T.D. 3613  
5" @ 3609  
Rust

9/1 1000' oil in 5 hrs  
500 acid Temp Pot. 109  
26.2 Gravity

9/8 " "

9/15 " "

9/22 " "

9/29 " "

10/6 " "

10/13 " "

**OVER**

1943  
10/20 26.2 Gravity  
10/27 " "  
10/3 " "  
11/10 Arb 3606  
5" @ 3609  
500 acid  
Pump 109 Pot.  
T.D. 3613  
Gravity 26.2

COMPLETED

10/27

Ellis

Map No. KANSAS Sec. 30 Twp. 11 R. 18WWell No. 1 T. W. McNeleyStanolind Company

FIRST REPORT Contractor

SE NE NE


990 Ft. from N. Line

\_\_\_\_\_ Ft. from S. Line

330 Ft. from E. Line

\_\_\_\_\_ Ft. from W. Line

## SECTION PLAT

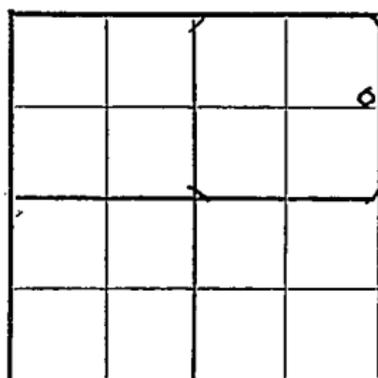

RIVERVIEW POOL

Location XXX

Rig up \_\_\_\_\_

Drilling and Remarks: \_\_\_\_\_

## RECORD

Cased \_\_\_\_\_ in., \_\_\_\_\_ ft.

Sand \_\_\_\_\_

Gas \_\_\_\_\_

Oil \_\_\_\_\_

Total Depth \_\_\_\_\_

## PRODUCTION

1st 24 hrs. Nat. \_\_\_\_\_

1st 24 hrs. after shot \_\_\_\_\_



Gas \_\_\_\_\_ Cu. Ft.

Dry Hole \_\_\_\_\_

Abandoned \_\_\_\_\_

Date

JUL 14 1943 19S. J. LEWIS Scout

 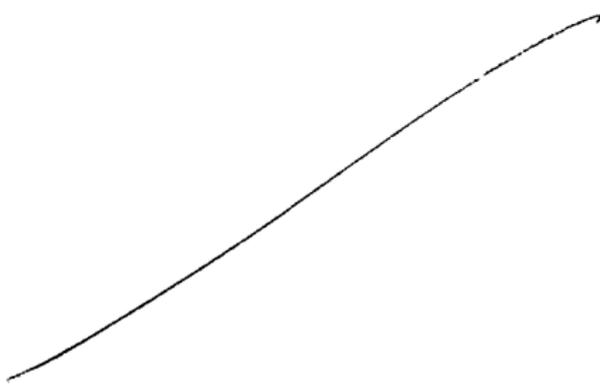

Misc Small Maps	<i>One</i>
Cards	<i>Best</i>
Tracing	<i>MS</i>
France Map	<i>MS</i>
Scarborough Map	<i>MS</i>
Moody Map	<i>MS</i>
Geological Dist.	
Moody Flat Book	



Misc. Small Maps *Ona*  
 Cards *Madge*  
 Tracts *MED*  
 France Map   
 Scarborough Map   
 Pierce Map *MED*  
 Geological Dept. \_\_\_\_\_  
 Pierce Plat Book \_\_\_\_\_