


Ellis

Section 30 Township 11 Range 18W

Well No. #1 W. Johnson Jr.

Company Shell

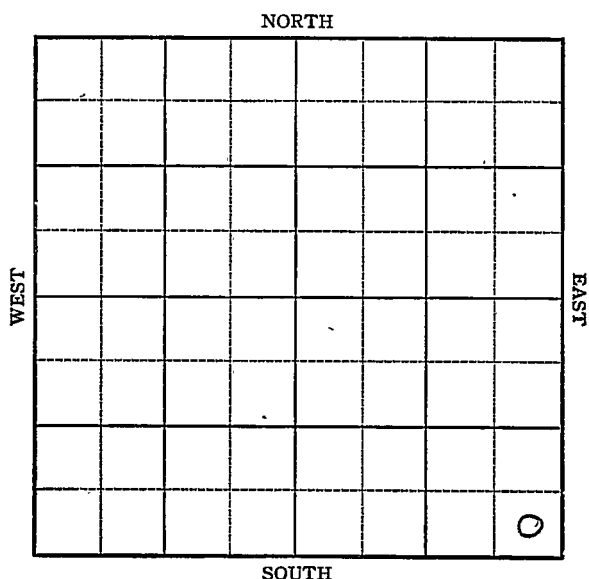

16

Ellis

Sec. 30 Twp. 11 R. 18W

Well No. #1 W. Johnson Jr. Farm

Shell Company


Riverview

 Ft. from N. Line

330 Ft. from S. Line

330 Ft. from E. Line

 Ft. from W. Line

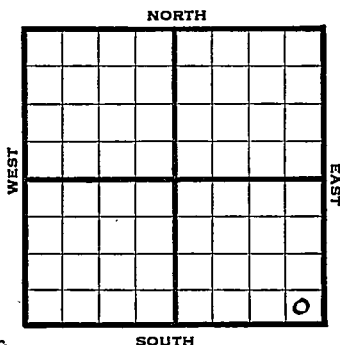

Elev. 2079

1944

R E P O R T

5/3

Location

5/10

Drlg. 365

5/17

8" - 1229

Drlg. 1940

5/24

Topoka 3083

Drlg. 3256

5/31

Lans 3318

Cong. 3582

Simp. 3594

Arb. 3601-06 TD

Sat. 4 $\frac{1}{2}$ " @ 3603 RUST

6/7

TD 3609-500 acid swb 178 oil in 3 hrs.

6/14

Arb. 3601

4 $\frac{1}{2}$ " @ 3603

500 acid

Echo Pot. 4109

TD 3609

Max. 3000

34.6 Grav.

COMPLETED

ANSAS

Pool Name RiverviewMap No. 77 Sec. 30 Twp. 11 R. 18WWell No. 1 W. Johnson Jr.Shell


Company

FIRST REPORT

Contractor

SE/C

SECTION PLAT

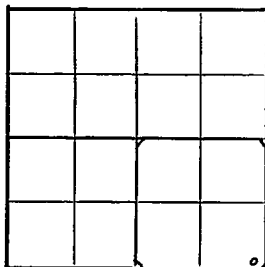 Ft. from N. Line330 Ft. from S. Line330 Ft. from E. Line Ft. from W. LineEllis CountyLocation XRig up Drilling and Remarks:

RECORD

Cased in., ft.Sand Gas Oil Total Depth

PRODUCTION

1st 24 hrs. Nat. 1st 24 hrs. after shot Gas Cu. Ft.Dry Hole Abandoned

Date

MAY 3 1944 19S. J. LEWIS

Scout

Riverview

Map No. 71 Sec. 30 Twp. 11 R. 18W

Well No. 1 W. Johnson Jr.

Company

Contractor

SECTION PLAT

Ft. from S. Line

Ft. from E. Line

Ft. from W. Line

Ellis County

Location

Rig up.

Drilling and Remarks:

Ar 83601

4 1/2 " 03603"

500 Acut

ECHO BX 4189

May 3000

34-6-4

RECORD

Cased _____ **in.** _____ **ft.** _____

Sand

Gas

Oil

Total Depth 3648

PRODUCTION

1st 24 hrs. Nat.

1st 24 hrs. after shot

Gas _____ Cu. Ft.

Drv Hole

Abandon

Date _____

JUN 14 1944

19

S. J. LEWIS

Scout