

# KANSAS

Ellis

Section 30 Township 11 Range 18W

Well No. 3 Johnson

Company R. Pierce et al

Riverview

NORTH


WEST

EAST

SOUTH

18

D

Sec. 30 Twp. 11 R. 18W

Well No. #3 Johnson Farm

R. Pierce et al Company


Riverview Pool (L.S.T., Cont.) NORTH

\_\_\_\_\_ Ft. from N. Line

330' Ft. from S. Line

\_\_\_\_\_ Ft. from E. Line

990' Ft. from W. Line

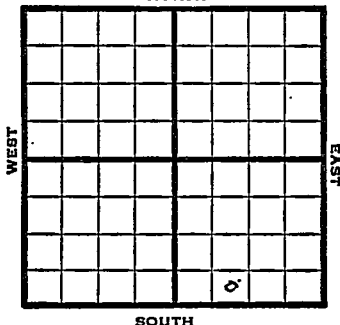

SE SW SE

SOUTH

1949	Elev 2081' REPORT
5/25	RUR
6/1	Dglg 3149' 8" @ 306'
6/7	Arbuckle 3642' TD 3655' 5" @ 3643'
6/15	"
6/21	TD 3663' 1250' acid
6/29	TD 3663' Arb. 3642' 5 @ 3643' 1250 acid Aband.
<b>ABANDONED</b>	

Map No. \_\_\_\_\_ Sec. 30 Twp. 11 R. 18W

Well No. 3 Johnson

R. Pierce et al. Company

L. S. T. Contractor

SE SW SE

FIRST REPORT  
SECTION PLAT

\_\_\_\_\_ Ft. from N. Line

330 Ft. from S. Line

\_\_\_\_\_ Ft. from E. Line

990 Ft. from W. Line


Ellis County

Location \_\_\_\_\_

Rig up \_\_\_\_\_

Drilling and Remarks:

R U R

RECORD

Cased \_\_\_\_\_ in., \_\_\_\_\_ ft.

Sand \_\_\_\_\_

Gas \_\_\_\_\_

Oil \_\_\_\_\_

Total Depth \_\_\_\_\_

PRODUCTION

1st 24 hrs. Nat. \_\_\_\_\_

1st 24 hrs. after shot \_\_\_\_\_

Gas \_\_\_\_\_ Cu. Ft.

Dry Hole \_\_\_\_\_

Abandoned \_\_\_\_\_

Date

MAY 25 1949 19

S. J. LEWIS

Scout

