

Sec. 30 Twp. 11 R. 18W ✓

Well No. #2 Johnson Farm

R. Pierce et al Company


Riverview Pool

990' Ft. from N. Line

_____ Ft. from S. Line

_____ Ft. from E. Line

990' Ft. from W. Line

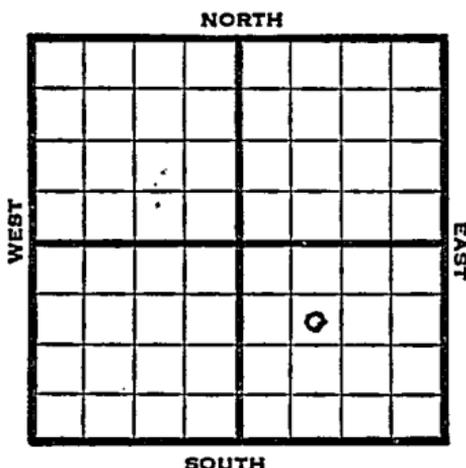

SE NW SE

1949

Elev 2072'

REPORT

4/13

Location

4/20

"

4/27

"

5/4

RUR

5/10

5" @ 288

Drlg 884'

5/18

Drlg 3150'

5/25

Arb. 3623-27'

TD 3627'

5" @ 3623'

6/1

TD 3639'

250 acid

800' oil

6/7

"

6/15

"

6/21

Swb 2½ bbls oil PH 8 hrs.

6/28

"

7/6

"

7/12

"

7/20

"

7/27

"

8/3

TD 3639'

Arb. 3623'

5" @ 3623'

250 acid P

Pump 101 Oil ≠ 5% W Pot

36° Gr.

Comp

COMPLETED

Map No. _____ Sec. 30 Twp. 11 R. 18W

Well No. 2 Johnson

R. Pierce etal. Company

FIRST REPORT

Contractor

SE NW SE

SECTION PLAT

990 Ft. from N. Line

_____ Ft. from S. Line

_____ Ft. from E. Line

990 Ft. from W. Line

Ellis County

Location X

Rig up _____

Drilling and Remarks:

RECORD

Cased _____ in., _____ ft.

Sand _____

Gas _____

Oil _____

Total Depth _____

PRODUCTION

1st 24 hrs. Nat. _____

1st 24 hrs. after shot _____

Gas _____ Cu. Ft.

Dry Hole _____

Abandoned _____

Date

APR 13 1949

19

S. J. LEWIS

Scout

Kansas

Riverview Pool

Map No. K71 Sec. 30 Twp. 11 R. 18WWell No. 2 JohnsonR. Pierce et al. Company**COMPLETE**

Contractor

SE NW SE

E12072
SECTION PLAT990 Ft. from N. Line Ft. from S. Line Ft. from E. Line990 Ft. from W. Line

Ellis County

Location _____

Rig up _____

Drilling and Remarks:

Cost 2629
5" @ 3623
2500 cost
Producing 101 oil 75%
W.P. 2
36-2-36

RECORD

Cased _____ in., _____ ft.

Sand _____

Gas _____

Oil _____

Total Depth 3629

PRODUCTION

1st 24 hrs. Nat. _____

1st 24 hrs. after shot _____

Gas _____ Cu. Ft.

Dry Hole _____

Abandoned _____

Date

AUG 3 1949 19

S. J. LEWIS Scout