

KANSAS

Ellis

Section 30 Township 11 Range 18WWell No. 1 JohnsonCompany R Pierce et al

Riverview Pool

NORTH

				2			

WEST

EAST

SOUTH

10

Ellis

KANSAS

Sec. 30 Twp. 11 R. 18W ✓

Well No. #1 Johnson Farm

R. Pierce et al Company

Riverview Pool


330' Ft. from N. Line

Ft. from S. Line

Ft. from E. Line

330' Ft. from W. Line

NW SE

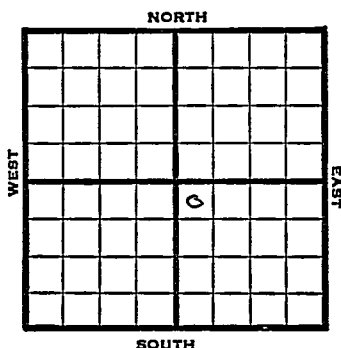

1949	Elev ²⁰⁷⁸ 2076' REPORT
3/16	8" @ 309'
3/23	Dr1g. 3010'
3/30	Arb. 3612'-21'
	TD 3612
	5"@ 3615'
4/6	TD 3625'
	2100' oil 36 hrs.
4/12	"
4/20	"
4/27	12 shots 3612-15
	500 acid
5/4	"
5/10	"
5/18	TD 3625'
	Arb. 3612'
	5"@ 3615'
	500 acid
	Pump 215 Oil Pot
	36° Gr.
	Comp
	COMPLETED

Kansas

Riverview Pool

Map No. _____ Sec. 30 Twp. 11 R. 18WWell No. 1 JohnsonR. Pierce et al.

Company

FIRST REPORT

Contractor

NW SE

SECTION PLAT

330 Ft. from N. Line


_____ Ft. from S. Line

_____ Ft. from E. Line

330

_____ Ft. from W. Line

Ellis County

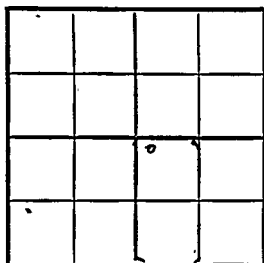

RECORD

Location _____

Cased _____ in., _____ ft.

Rig up _____

Sand _____

Drilling and Remarks:

Gas _____

Oil _____

8" @ 309

Total Depth _____

PRODUCTION

1st 24 hrs. Nat. _____

1st 24 hrs. after shot _____

Gas _____ Cu. Ft.

Dry Hole _____

Abandoned _____

Date

MAR 16 1949 19

S. I. LEWIS

Scout

Map No. K71 Sec. 30 Twp. 11 R. 18W

Well No. 1 Johnson

R. Pierce etal.

Company

COMPLETE

Contractor

NW SE


E. 20 78
SECTION PLAT

330 Ft. from N. Line

Ft. from S. Line

Ft. from E. Line

330 Ft. from W. Line

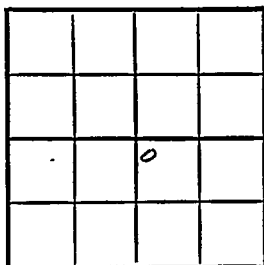

Ellis County

Location

Rig up

Drilling and Remarks:

CR 3612

5" CR 3615

5000 cu ft

Run 2 1/2 in Oil Port

36 2/3

RECORD

Cased _____ in., _____ ft.

Sand _____

Gas _____

Oil _____

Total Depth 3625

PRODUCTION

1st 24 hrs. Nat. _____

1st 24 hrs. after shot _____

Gas _____ Cu. Ft.

Dry Hole _____

Abandoned _____

Date

MAY 18 1949 19

S. J. LEWIS Scout