

Section 30 Township 11 Range 17 W

Well No. # 1 Peavey

Company Isern Drlg.

NORTH

	0						

4

WEST

EAST

SOUTH

Ellis

KANSAS

SEC.	TWP.	R.
30	11	17 W

WELL NO. # 1 Peavey FARM

COMPANY Isern Drlg.

CONTRACTOR Isern Drlg.

Bemis-Shutts Pool


330 Ft. from N. Line

Ft. from S. Line

Ft. from E. Line

990 Ft. from W. Line

NE NW NW

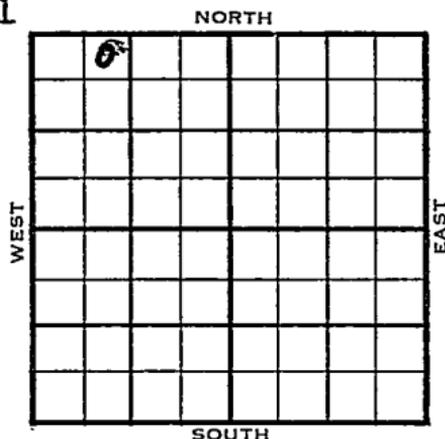

1953	ELEVATION 2091'	REPORT
------	-----------------	--------

9/30 BUR

10/7 8" @ 225
Drlg. 1867'

10/14 Heeb 3290', Tor 3311', Lans 3336'
DST 3363-81', failed
Drlg. 3550'

10/21 Spud 10-2-53
D&A'
TD 3693
8" @ 225
Heeb 3290, Tor 3311, Lans 3336
DST 3363-81, failed
Arb. 3634
TD 3693
D&A

ABANDONED

County Ellis State Kansas

Sec. 30 (Blk. Twp.) 11 (Sur. Rge.) 17W Map No.

Operator Isern Drig.

Well No. 1 Farm Peavey

Elev. Location NE NW NW

0							

330 Ft. From N Line NW

990 Ft. From W Line Quarter

1st. Report SEP 30 1953

Completion

Remarks

Isern Drig. - Contr.

Spudding Date

Drig. Data Bemis-Shutts Pool

RUR

County Ellis State Kansas

Sec. 30 (Blk. 11 (Sur. 17W (Rge. Map No.)

Operator Isern Drlg.

Well No. 1 Farm Peavey

Elev. 2091 Location NE NW NW

0					
ABANDONED					

330 Ft. From N Line NW

990 Ft. From W Line Quarter

Ist. Report

OCT 21 1955

Completion

Remarks Bemis-Shutts Pool

Isern Drlg. - Contr.

Spudding Date 10-2-53

Drlg. Data D & A TD 3693

8" @ 225 Heeb. 3290 Tor. 3311

Lans. 3336 DST 3363-81 failed

Arb. 3634 TD 3693

D & A

64