

KANSAS


Ellis


FORM 51 5M PETROL

Section 30 Township 11 Range 17W

Well No. #3 Hadley "L"

Company Champlin Ref.

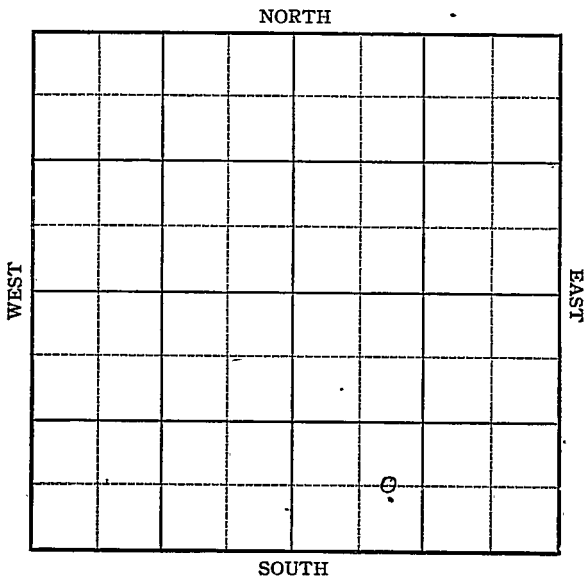

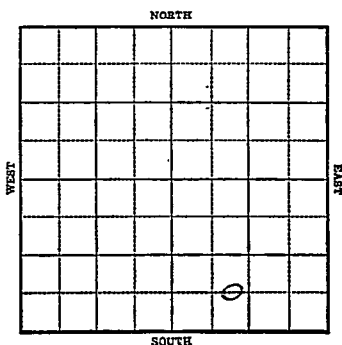Sec. 30 Twp. 11 R. 17-WWell No. #3 Hadley "L" FarmChamplin Ref. Company Ft. from N. Line660 Ft. from S. Line Ft. from E. Line990 Ft. from W. LineElev. 2104

1943

R E P O R T

12/1	Location.
12/8	"
12-15	"
12/22	"
12/29	Derrick
1944	
1-5	Rotary
1-12	Drlg 1210'
1/19	Anhy 1325 Drlg. 3225
1/26	7" @ 3614' Rust
2/2	10" @ 1230 Cong 3574 Arb 3593 TD 3603 4" @ 3503 corrected
2/8	" "
2/15	TD 3613-5 oil per hr for 4 hrs. 2000 acid.

OVER

1944
2/23

4" @ 3503
Arb 3593
TD 3613
2000 acid
Pump 260 Pot.
Gravity 34

COMPLETED

Ellis

KANSAS

Map No. 77 Sec. 30 Twp. 11 R. 17WWell No. 3 Hadley "L"

Champlin Ref.

Company

FIRST REPORT

Contractor

C E L SW SE

SECTION PLAT .

Ft. from N. Line

660 Ft. from S. Line

Ft. from E. Line

990 Ft. from W. Line

Bemis Pool

Location X

Rig up

Drilling and Remarks:

RECORD

Cased _____ in., _____ ft.

Sand _____

Gas _____

Oil _____

Total Depth _____

PRODUCTION

1st 24 hrs. Nat. _____

1st 24 hrs. after shot _____

Gas _____ Cu. Ft.

Dry Hole _____

Abandoned _____

Date

DEC 1 1942 19

S. J. LEWIS Scout

M. P. 114025 *Ena*
Madge
ME L
✓
ME L
 Flat P. 114025

Ellis

KANSAS

Map No. 71 Sec. 30 Twp. 11 R. 17WWell No. 3 Hadley "L"

Champlin Ref.


Company

COMPLETED

Contractor

C E L SW SE

SECTION PLAT

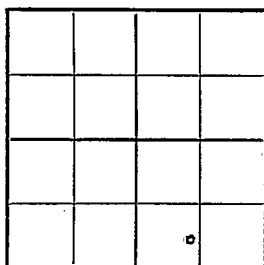 Ft. from N. Line660 Ft. from S. Line Ft. from E. Line990 Ft. from W. Line

Bemis Pool

Location Rig up

Drilling and Remarks:

*Cu x 3593**4" @ 3583**2000 acial**Pump 260 Bx.**34-6-92*

RECORD

Cased in., ft.Sand Gas Oil Total Depth 3613

PRODUCTION

1st 24 hrs. Nat. 1st 24 hrs. after shot Gas Cu. Ft.Dry Hole Abandoned

Date


FEB 23 1944 19

S. J. LEWIS Scout

127.

12

22

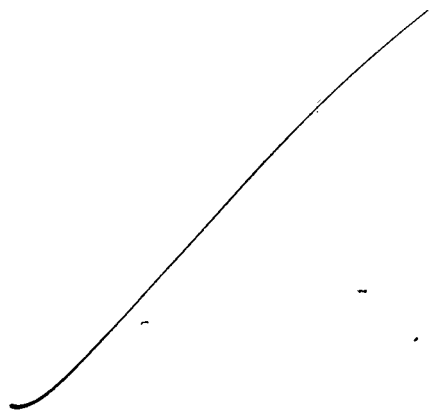

Miss Small Maps	<i>Osma</i>
Card's	<i>Madge</i>
Trading	<i>ME</i>
Trance Map	<i>[Signature]</i>
Warborough Map	<i>[Signature]</i>
Moody Map	<i>ME</i>
Geological Dept.	
Moody Plat Book	