

KANSAS

Ellis


FORM 51 5M 1-42 PETROL

Section 30 Township 11 Range 17-W

Well No. #2 Hadley "L"

Company Champlin Refining

Demis Pool NORTH

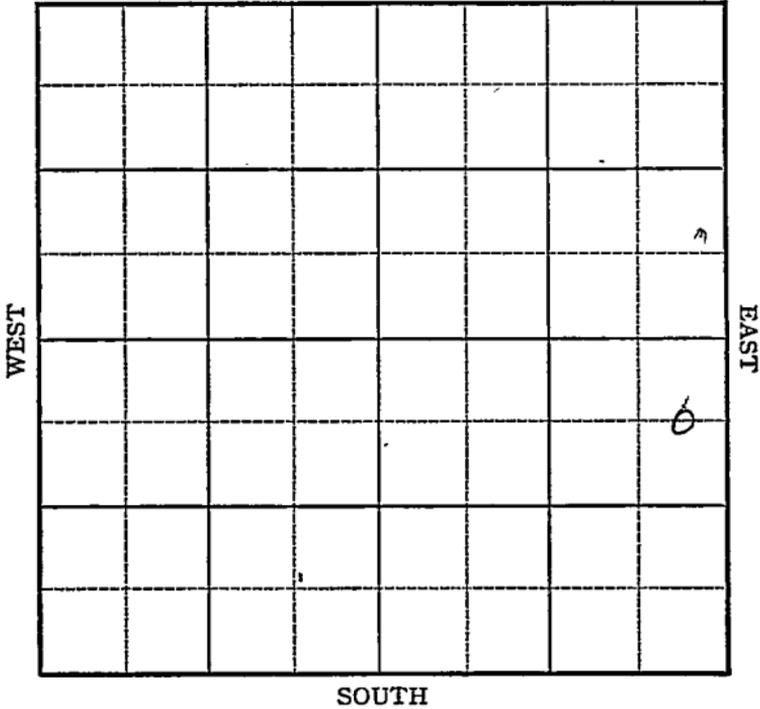

KANSAS

Ellis
R. 17W

Sec. 30 Twp. 11

Well No. #2 Hadley "L" Farm

Champlin Refining Company


Bemis Pool

660 Ft. from N. Line

Ft. from S. Line

330 Ft. from E. Line

Ft. from W. Line

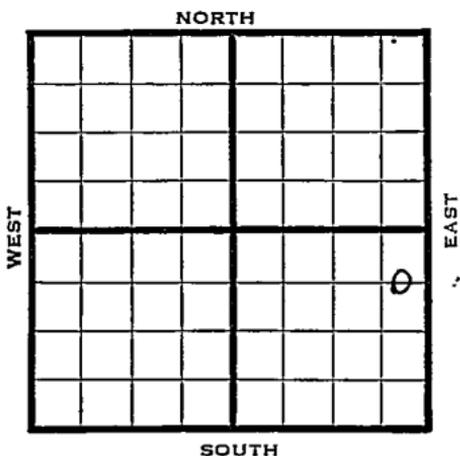

C EL NE SE Elev. 2038

1942

REPORT

11/18 . Location
 11/24 " "
 12/2 Anhy 1278
 8" @ 1275
 WOC
 12/9 Drlg. 1410
 12/16 Arb 3536
 TD 3568
 4" @ 3568 Rust.
 12/22 Arb. 3536
 4" @ 3568'
 T.D. 3568'
 61 shots 3568-51
 1500 gals. acid
 Pump 100 Pot.
 Gravity 36.4

COMPLETED

KANSAS

Map No. 71 Sec. 30 Twp. 11 R. 17W

Well No. 2 Hadley "L"

Champlin Refining Company

FIRST REPORT Contractor

C E L N E S E

SECTION PLAT

660 Ft. from N. Line

_____ Ft. from S. Line

330 Ft. from E. Line

_____ Ft. from W. Line

BEMIS POOL

Location XXX

Rig up _____

Drilling and Remarks:

RECORD

Cased _____ in., _____ ft.

Sand _____

Gas _____

Oil _____

Total Depth _____

PRODUCTION

1st 24 hrs. Nat. _____

1st 24 hrs. after shot _____

Gas _____ Cu. Ft.

Dry Hole _____


Abandoned _____

Date

NOV 18 1942 19

S. J. LEWIS Scout

Please check spot, as we think this well is in the southeast quarter.

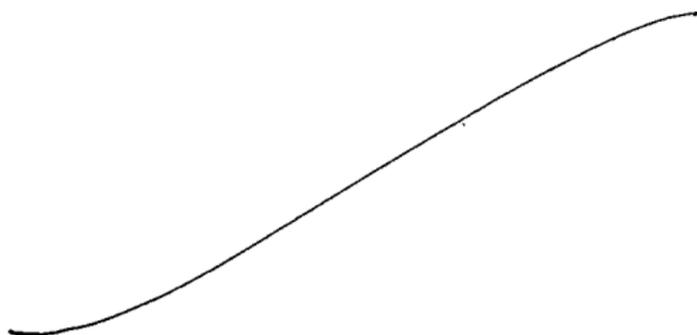

Misc Small Map	<i>One</i>
Cards	<i>Books</i>
Tracing	<i>MB</i>
France Map	<i>MB</i>
Scarborough Map	<i>MB</i>
Moody Map	<i>MB</i>
Geological Dept.	
Moody Plat Book	

Ellis

KANSAS / Map No. / Sec. 30 Twp. 11 R. 17WWell No. 2 Hadley "L"Champlin Refining CompanyCOMPLETED Contractor

C E L N E S E

SECTION PLAT

660 Ft. from N. Line Ft. from S. Line330 Ft. from E. Line Ft. from W. Line

			o

BEMIS POOL

Location Rig up

Drilling and Remarks:

*Cor 83536**4" @ 8568.**6 1/2 hrs to 3538-51**1500 Bbl**Pump 100 P.Y.**364 Gr*

RECORD


Cased in., ft.Sand Gas Oil Total Depth 8568.

PRODUCTION

1st 24 hrs. Nat. 1st 24 hrs. after shot Gas Cu. Ft.Dry Hole Abandoned

Date

DEC 22 1942 19S. I. LEWIS Scout

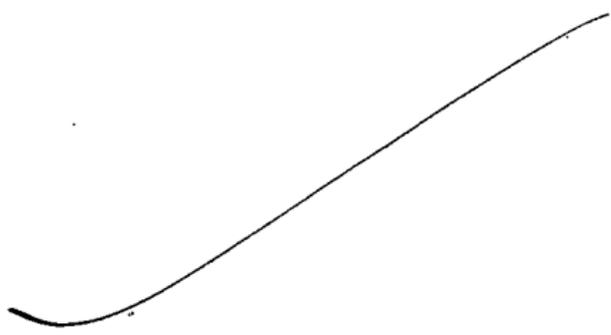

Misc Small Maps	<i>One</i>
Cards	<i>Boat</i>
Tracing	<i>MB</i>
France Map	<i>[scribble]</i>
Scarborough Map	<i>[scribble]</i>
Moody Map	<i>MB</i>
Geological Dept	
Mosdy Flat Book	