


Section 30 Township 11 Range 17W

Well No. 1 Hadely "L"

Company Champlin Refining

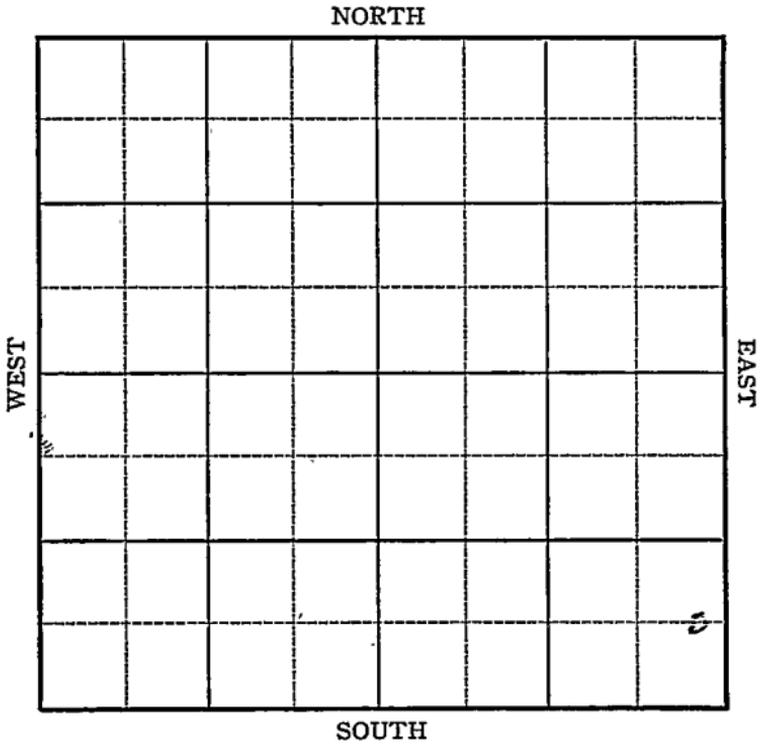

Sec. 30 Twp. 11 R. 17-W

Well No. #1 Hadely "L" Farm

Champlin Refining Company

Bemis Pool


_____ Ft. from N. Line

660 Ft. from S. Line

330 Ft. from E. Line

_____ Ft. from W. Line

C EL SE SE *Elev. 2110*

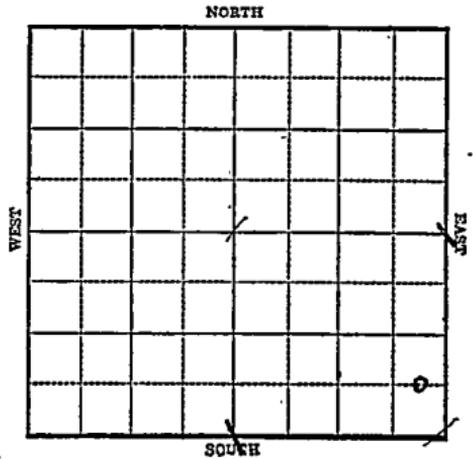

1942

R E P O R T

- 10/21 Rotary
- 10/28 "
- 11/4 Anhy 1335
8" @ 1340
Drlg. 2675
- 11/11 Arb. 3609-37 TD
4" @ 3637' Rust
- 11/18 " " "
- 11/24 " " "
- 12/2 to perforate
- 12/9 " "
- 12/16 " "
- 12/22 71 shots 3612-25 CO
- 12/29 " "
- 1943
- 1/6 " "
- 1/13 Pump 84 Temp. Pot.

OVER

1943

1/20

Arb 3609

4" Casing set 3637

71 shots 3612-25

4000 acid pump 600 Pot.

34.6 Gravity.

FD 3637'

COMPLETED

Map No. 71 Sec. 30 Twp. 11 R. 17WWell No. 1 Hadely "L"Champlin Refining CompanyFIRST REPORT Contractor

C E L S E S E

SECTION PLAT

 Ft. from N. Line660 Ft. from S. Line330 Ft. from E. Line Ft. from W. Line

			0

BEMIS POOL

Location Rig up

Drilling and Remarks:

Rotary

RECORD

Cased in., ft.Sand Gas Oil Total Depth

PRODUCTION

1st 24 hrs. Nat. 1st 24 hrs. after shot Gas Cu. Ft.Dry Hole Abandoned

Date

OCT 21 1942 19S. J. LEWIS Scout

Misc. Small Maps	<i>oil</i>
Cards	<i>Boat</i>
Tracing	<i>MB</i>
France Map	<i>MB</i>
Scarborough Map	<i>MB</i>
Moody Map	<i>MB</i>
Geological Dept.	
Moody Plat Book	

KANSAS
 Map No. 11 Sec. 30 Twp. 11 R. 17W

Well No. 1 Hadley "L"

Champlin Refining Company

COMPLETED Contractor

C E L S E S E

_____ Ft. from N. Line

660 Ft. from S. Line

330 Ft. from E. Line

_____ Ft. from W. Line

SECTION PLAT

			o

BEMIS POOL

Location _____

Rig up _____

Drilling and Remarks:

Ce 43609
4 "C 3637
71 shots to 3612-25
4000 acid
Pump .600 P.D.
346 Gr

RECORD

Cased _____ in., _____ ft.

Sand _____

Gas _____

Oil _____

Total Depth 3637

PRODUCTION

1st 24 hrs. Nat. _____

1st 24 hrs. after shot _____

Gas _____ Cu. Ft.


Dry Hole _____

Abandoned _____

Date

JAN 20 1943 19

S. J. LEWIS Scout

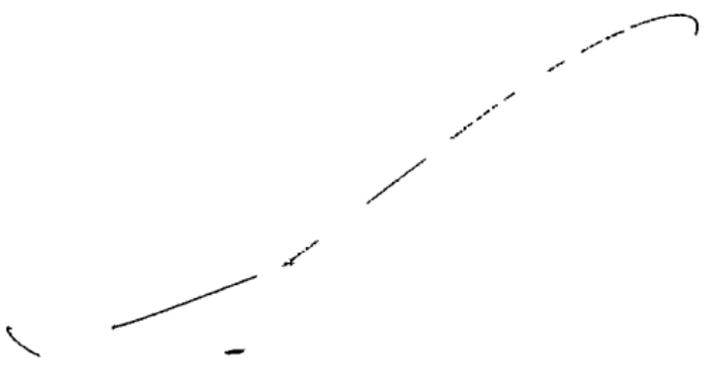

Misc. Small Maps	<i>One</i>
Cards	<i>Boat</i>
Tracing	<i>MB</i>
France Map	<i>✓</i>
Scarborough Map	<i>MB</i>
Moody Map	<i>MB</i>
Geological Dept.	
Acidylat Book	