


Section 30 Township 11 Range 17W

Well No. #2 Hadley "A"

Company Champlin Ref.

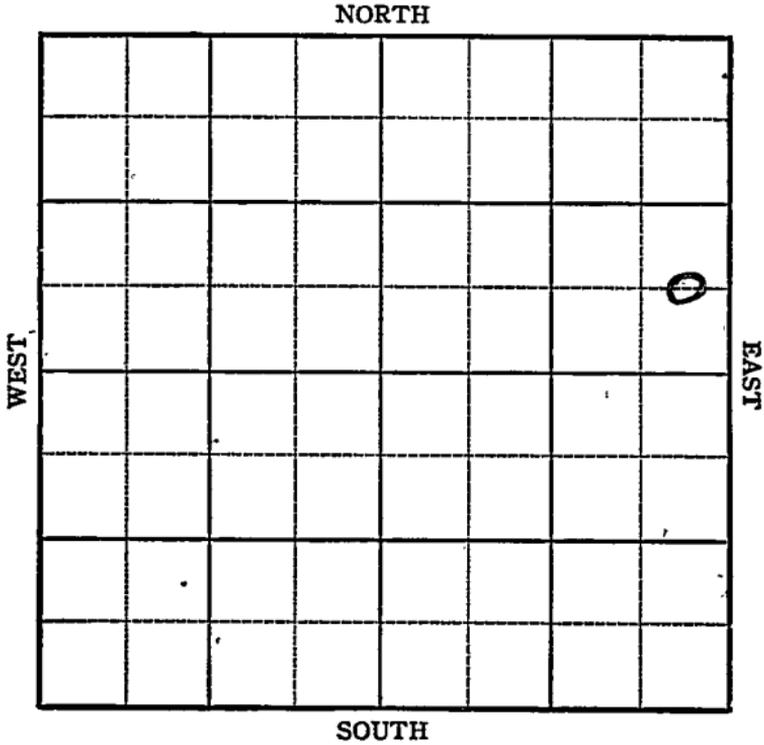

KANSAS

Ellis

Sec. 30 Twp. 11 R. 17-W

Well No. #2 Hadley "A" Farm.


Champlin Ref. Company

_____ Ft. from N. Line

660 Ft. from S. Line

330 Ft. from E. Line

_____ Ft. from W. Line

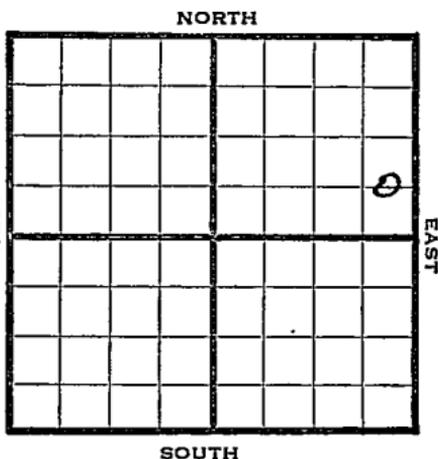

Bemis Elev. 2105

REPORT.

~~1944~~

- | | |
|------|--|
| 3/15 | Location. |
| 3/22 | " |
| 3/29 | " |
| 4/5 | Rotary |
| 4/12 | " |
| 4/19 | Drlg. 2300 |
| 4/26 | Drlg. 3110 |
| 5/3 | Drlg. 3605 |
| 5/10 | Sooy 3600
Arb 3604-15
TD 4" @ 3605
RUST SSO |
| 5/17 | " " |
| 5/31 | Arb 3604
4" @ 3605
TD 3655
Water |

ABANDONED

KANSAS
 Map No. 7 / Sec. 30 Twp. 11 R. 17 W

Well No. 2 Hadley "A"

Champlin Ref. Company

FIRST REPORT Contractor

C E L S E N E

SECTION PLAT

 Ft. from N. Line

660 Ft. from S. Line

330 Ft. from E. Line

 Ft. from W. Line

			o

Bemis Pool

Location X

Rig up

Drilling and Remarks:

RECORD

Cased in., ft.

Sand

Gas

Oil

Total Depth

PRODUCTION

1st 24 hrs. Nat.

1st 24 hrs. after shot

Gas Cu. Ft.

Dry Hole

Abandoned

Date

MAR 15 1944 19

S. J. LEWIS Scout

KANSASPool Name Bemis PoolMap No. 71 Sec. 30 Twp. 11 R. 17WWell No. 2 Hadley "A"

Champlin Ref.

Company _____

ABANDONED

Contractor _____

C E L S E N E

SECTION PLAT

_____ Ft. from N. Line

660

_____ Ft. from S. Line

330

_____ Ft. from E. Line

_____ Ft. from W. Line

Ellis County

Location _____

Rig up _____

Drilling and Remarks:

*See #3604**4" @ 3605.**Water*

RECORD

Cased _____ in., _____ ft.

Sand _____

Gas _____

Oil _____

Total Depth 3655

PRODUCTION

1st 24 hrs. Nat. _____

1st 24 hrs. after shot _____

Gas _____ Cu. Ft.

Dry Hole _____

Abandoned _____

Date

MAY 3 1 1944 19

S. J. LEWIS Scout