


Section 30 Township 11 Range 17-W

Well Number #1-Hadley

Company Champlin O & R

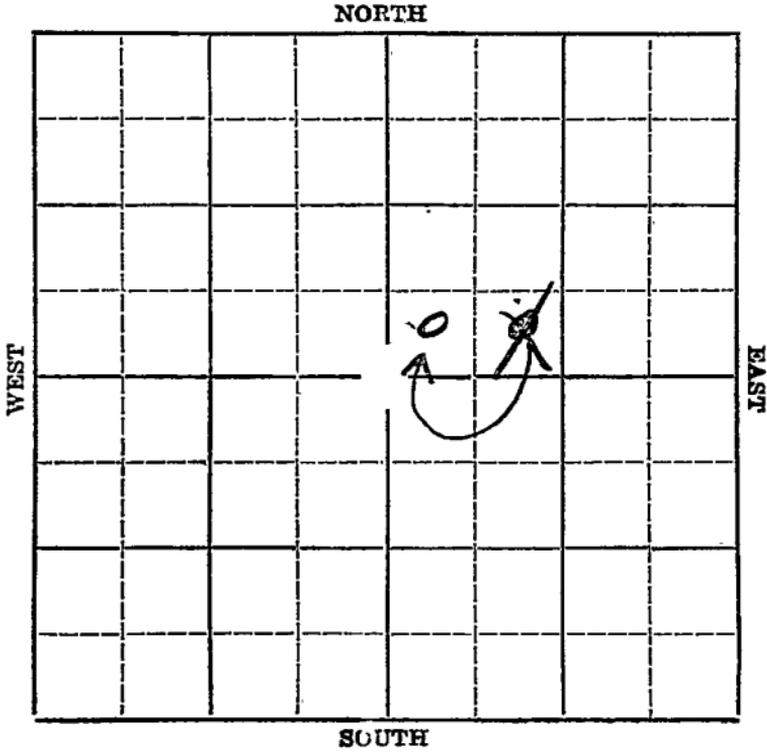

Map No. KANSAS Sec. 30 Twp. 11 R. 17W

Well No. #1 Hadley Farm

Champlin O & R Company


 Ft. from N. Line

330' Ft. from S. Line

 Ft. from E. Line

330
~~330'~~ Ft. from W. Line

Elev. 2103

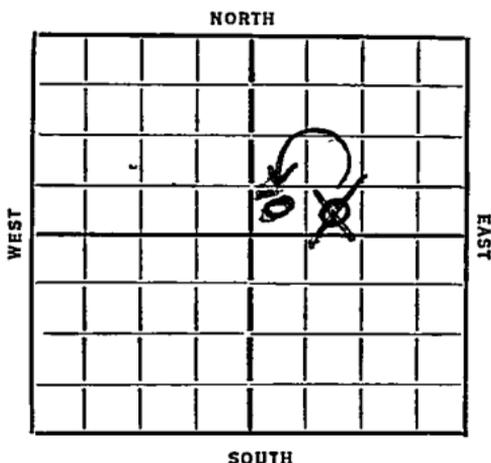

Date	REPORT
1936	
7/1	Rig on ground.
7/9	Building rig.
7/16	Rig.
7/23	Spud 160'.
7/30	Spud 400'.
8/6	15" @ 426'. Drlg.
8/13	Rigging up rotary.
8/20	Drlg. 1157'.
8/27	Anhydrate 1356'. Drlg. 2323'.
9/3	Drlg. 2825'.
9/10	Drlg. 3205'.
9/18	9" @ 3367'. RUST.
9/24	--
10/1	Lansing 3389', Show oil 3420-25'. TD 3487'. Under ream 9".
10/8	Basil sand 3610'. Hole full of water 3616'. -18'. Drlg. 3624'.
10/15	No basil sand Conglomerate 3600'. Sil. ³⁷⁷⁰ 3613 ' , 6" @ 3687'. Drlg. 3750'
10/22	6" @ 3777'. Drlg. 3784'.
10/29	Shut down at 3800'.

OVER

1936

11/6--Shut down 3800

11/10--Sil. 3790 Corrected

T. D. 3830

H. F. W.

D. & A.

ABANDONED

Map No. 71 Sec. 30 Twp. 11 R. 17

Well No. 1 Hadley

Champlin Oil & R. Company

Contractor

SECTION PLAT

		o	

_____ Ft. from N. Line

330 Ft. from S. Line

_____ Ft. from E. Line

990 Ft. from W. Line

FIRST REPORT

Location _____

Rig up _____

Drilling and Remarks:

ROG

RECORD

Cased _____ in., _____ ft.

Sand _____

Gas _____

Oil _____

Total Depth _____

PRODUCTION

1st 24 hrs. Nat. _____

1st 24 hrs. after shot _____

Gas _____ Cu. Ft.

Dry Hole _____

Abandoned _____

Date **JUL 1 1936**

[Handwritten scribbles and lines across the top half of the page]

[Handwritten initials or signature]

Returned	<i>[Handwritten mark]</i>
Cards	<i>[Handwritten mark]</i>
Tracing	<i>[Handwritten mark]</i>
France Map	<i>[Handwritten mark]</i>
Scarborough Map	<i>[Handwritten mark]</i>
Moody Map	<i>[Handwritten mark]</i>
Scarborough Plat Book	<i>[Handwritten mark]</i>
Moody Plat Book	<i>[Handwritten mark]</i>

KANSAS

Map No. 71 Sec. 30 Twp. 11 R. 17W

Well No. 1 Hadley

Champlin Ref. Company

Contractor

SECTION PLAT

_____ Ft. from N. Line

330 Ft. from S. Line

_____ Ft. from E. Line

330 Ft. from W. Line

		0	

CORRECTION

Location _____

Rig up _____

Drilling and Remarks:

Reported
S&B W E

RECORD

Cased _____ in., _____ ft.

Sand _____

Gas _____

Oil _____

Total Depth _____

PRODUCTION

1st 24 hrs. Nat. _____

1st 24 hrs. after shot _____

Gas _____ Cu. Ft.

Dry Hole _____

Abandoned _____

Date

JUL 15 1936

S. J. LEWIS

Scout



Retained	<i>R. J. Cook</i>

KANSAS

Map No. 71 Sec. 30 Twp. 11 R. 17W

Well No. 1 Hadley

Champion Ref. Company

Contractor

SECTION PLAT

		0	

_____ Ft. from N. Line

320 Ft. from S. Line

_____ Ft. from E. Line

330 Ft. from W. Line

ABANDONED

Location _____

Rig up _____

Drilling and Remarks:

Si 3790 @ selected

HPW

D & H

RECORD

Cased _____ in., _____ ft.

Sand _____

Gas _____

Oil _____

Total Depth 3830

PRODUCTION

1st 24 hrs. Nat. _____

1st 24 hrs. after shot _____

Gas _____ Cu. Ft.

Dry Hole _____

Abandoned _____

Date

NOV 10 1936 19

S. J. LEWIS Scout

Paul

[Large handwritten scribble]

Returned
Cards	<i>Paul</i>
Tracing	<i>J.P.</i>
France Map	<i>[checkmark]</i>
Scarborough Map	<i>[checkmark]</i>
Moody Map	<i>[checkmark]</i>
Scarborough Plat Book
Moody Plat Book