


Section 30 Township 11 Range 17 W

Well No. # 1 Peavey "B"

Company Walters Drig.

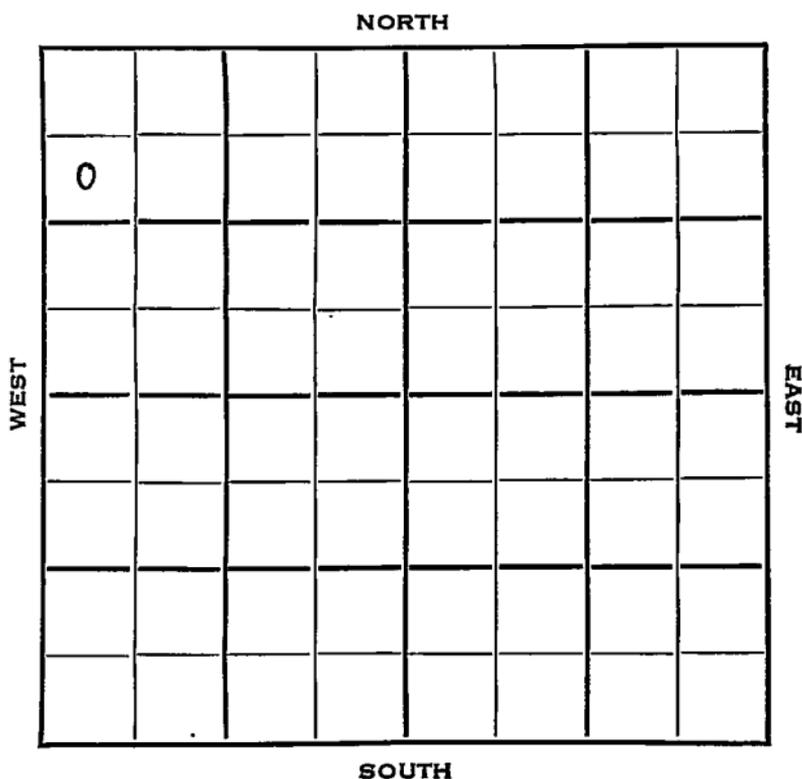

Ellis KANSAS


SEC. 30	TWP. 11	R. 17W ✓
------------	------------	-------------

WELL NO. 1 Peavey "B" FARM

COMPANY Walters Drlg.

CONTRACTOR Walters Drlg.
Burnett Pool

990 Ft. from N. Line
 _____ Ft. from S. Line
 _____ Ft. from E. Line
 330 Ft. from W. Line

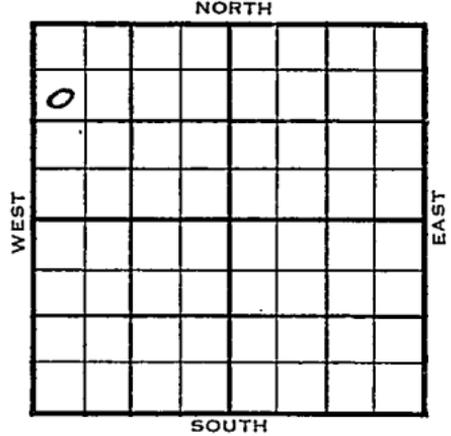

SW NW NW

	ELEVATION	REPORT
1953	1945'	

12/30 Spud 12-28-53
8" @ 182', WOC

1954
1/6 Anhy 1195'
Drlg. 3050'

1/13 Spud 12-28-53
D & A
TD 3550'
8" @ 182'
Anhy 1195', KC 3200', Cong 3472'
Arb 3503'
TD 3550'
D & A

ABANDONED

County Ellis State Kansas

Sec. 30 (Blk. 11 (Sur. 17W Map No. 11) (Twp.) (Rge.)

Operator Walters Drlg.

Well No. 1 Farm Peavey "B"

Elev. _____ Location SW NW NE

0					

990 Ft. From N Line NW

330 Ft. From W Line Quarter

Ist. Report DEC 30 1953

Completion _____

Remarks _____

Walters Drlg. - Contr.

Spudding Date 12-28-53

Drlg. Data Burnett Pool

8" @ 182 WOC

