

Ellis

KANSAS

30


11S

20W

SECTION _____ TOWNSHIP _____ RANGE _____

WELL NO. #1 Nicholson "A"

COMPANY Mallonee Drlg.

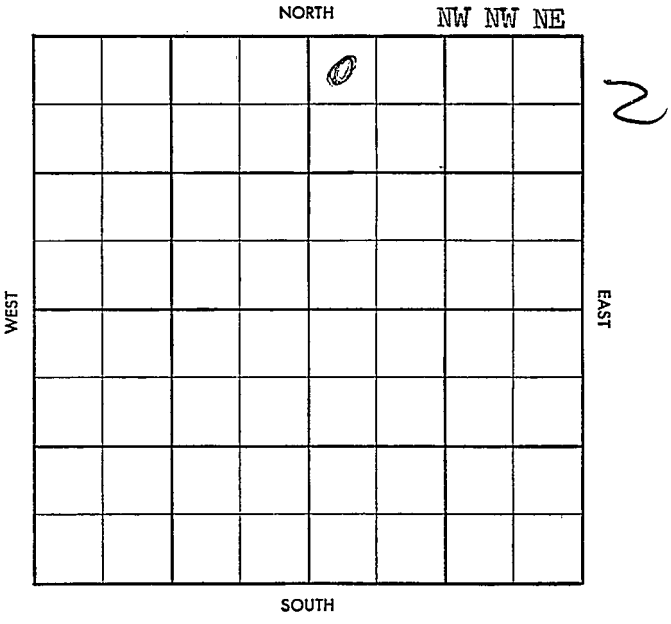

S-513-A

CO. ~~ELIAS~~ ELEV. 2232
SEC. 30 TWP. 11 RGE. 20W
COMPANY Mallonee Drlg. NO. 1

CO.
DEC 18 57
COMPLETE

FARM Nicholson "A"

LOC. NW 1/4 NE

GEOL. -
CONTR. Co. Tools
POOL Nicholson
SPUD 10-30-57

MIRT NOV 5 57 85' 2 1/2 125 A 1642
 Ø 2930 TP 3266
 Hb 3482 TR 3506 Lsg. 3518
 DST 3579 - 3608 60" 120' HOCM
 BHP 995 - 995 1/20" FP 35-95
 DST 3608 - 35 60" 38' MSW
 BHP 1154 - 1100 1/20" FP 48-48
 DST 3690 - 3730 60" 10' HOCM
 160' OCM 20' W BHP 1085
 - 1025 FP 40 - 120 ahead

NOV - 57 A 16 38 29 RTD 3953
 5 1/2 3852/100 W OCT
 DEC 4 57 16/3720-24
 \$ BT ph 50' 20 W 2 hrs
 2500A \$ W 550 P B 3710
 20/3697 - 3702 2500A
 \$ 15 BFPH 20' 20 W 2 hrs P B 3636
 20/3602 - 07 \$ 18 BFPH
 25' 20 W 2 hrs DP 3636
 BP 3710 \$ 18 BT-PH 4090
 W 2 hrs pop x

25 BDP 4 D 9 W

Lsg 3602 - 3702