


KANSAS Ellis

FORM 51 5M 11-44 PETROL

Section 30 Township 11 Range 20W

Well No. 2 Nicholson

Company Phil-Han

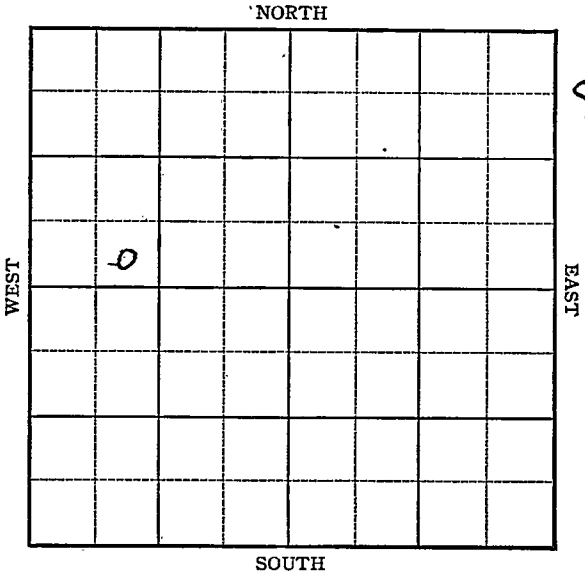

KANSAS Ellis County

Sec. 30 Twp. 11 R. 20W

Well No. #2 Nicholson Farm


Phil-Han Company

Nicholson
Ft. from N. Line

330 Ft. from S. Line

Ft. from E. Line

990 Ft. from W. Line

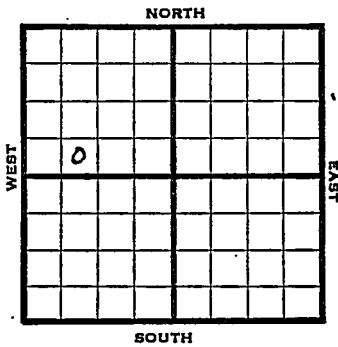

SE SW NW

1946

Elev. 2285' REPORT

5/29

RUR

6/5

8" @ 1433
Drlg. 2450'

6/19

Arb 3921'
TD 3931'

ABANDONED

KANSAS

Kansas Pool Name Nicholson

Map No. _____ Sec. 30 Twp. 11 R. 20W

Well No. 2 Nicholson

Phil-Han Company

FIRST REPORT Contractor

SE SW NW

SECTION PLAT

_____ Ft. from N. Line

330 Ft. from S. Line

_____ Ft. from E. Line

990 Ft. from W. Line

	o		

Ellis County

Location _____

Rig up _____

Drilling and Remarks:

RUR

RECORD

Cased _____ in., _____ ft.

Sand _____

Gas _____

Oil _____

Total Depth _____

PRODUCTION

1st 24 hrs. Nat. _____

1st 24 hrs. after shot _____

Gas _____ Cu. Ft.

Dry Hole _____

Abandoned _____

Date

MAY 29 1946 19 _____

S. J. LEWIS Scout

KANSAS

Kansas Pool Name Nicholson PoolMap No. 70 Sec. 30 Twp. 11 R. 20WWell No. 2 NicholsonPhil-Hen Company

ABANDONED

Contractor

SE SW NW

E 1, 2255
SECTION PLAT Ft. from N. Line330 Ft. from S. Line Ft. from E. Line990 Ft. from W. Line

Ellis CountyLocation Rig up

Drilling and Remarks:

Core 3921

RECORD

Cased in., ft.Sand Gas Oil Total Depth 3931

PRODUCTION

1st 24 hrs. Nat. 1st 24 hrs. after shot Gas Cu. Ft.Dry Hole Abandoned

Date

JUN 19 1946S. J. LEWIS Scout