


Section 30 Township 11 Range 20W

Well No. 1 Wishnuck

Company D. R. Lauck

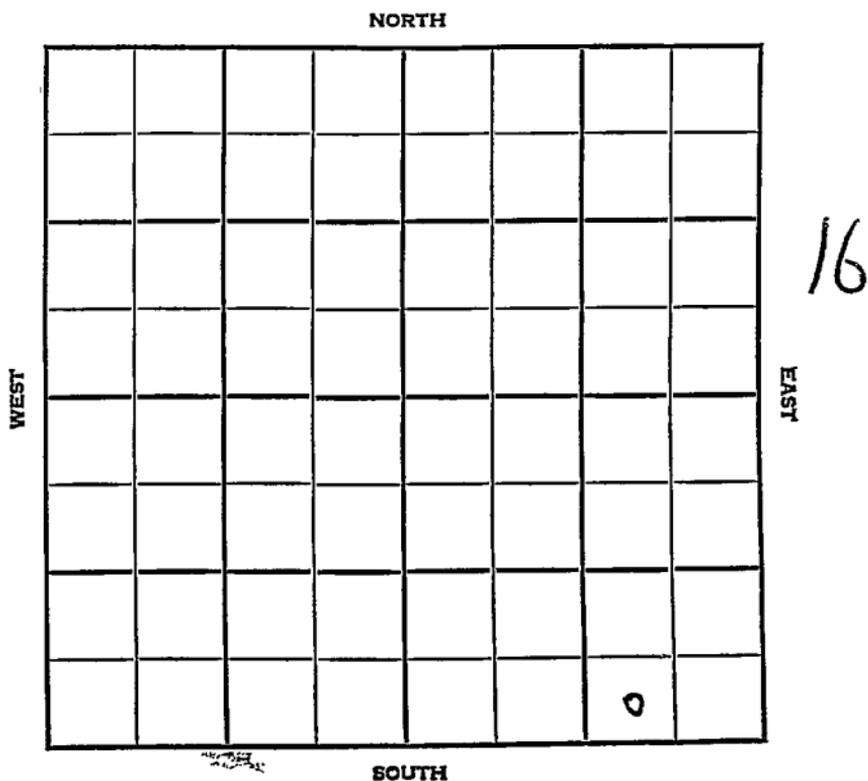


Ellis  
 SEC. 30 TWP. 11 R. KANSAS 20W ✓

WELL NO. 1 Wishnuck FARM  
 COMPANY

CONTRACTOR D. R. Lauek

Lauck-Contr  
 SE Ubert Pool

\_\_\_\_\_ Ft. from N. Line  
 330 \_\_\_\_\_ Ft. from S. Line  
 990 \_\_\_\_\_ Ft. from E. Line  
 \_\_\_\_\_ Ft. from W. Line

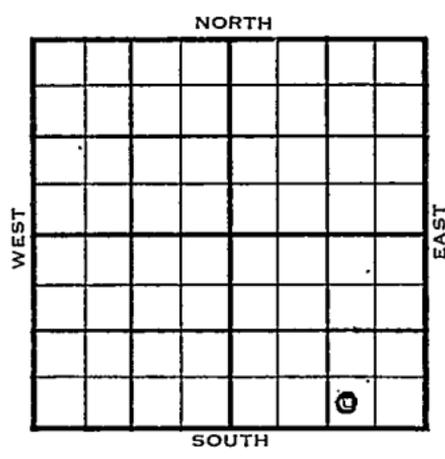

SW SE SE

	ELEVATION	REPORT
1954	2228	

6/2 Spud 5-21-54  
 8" @ 154 Arb. 3848 DST ? open 1/2 hr. Rec  
 Rec. 30' ocm/120' free oil 740# 5" @

8-11 Spdg 5-21-54  
 Oil well  
 TD 3869  
 8" @ 154  
 Heeb 3507 Tbr. 3527 Lens. 3544  
 BKC 3771 Marm. 3820 Arb. 3848  
 D ST 3847-53 open 1/2 hr. Rec. 12'  
 mud 1000#  
 DST 3850-56 open 1/2 hr. Rec. 30' ocm  
 120' free oil 740#  
 TD 3856  
 5" @ 3850  
 DD 3869 500 A 16 qt/ S/ 5 boph 10 hr  
 Comp. 50 bopd.

COMPLETED



