


Section 31 Township 11 Range 16W

Well No. #2 Planters St. Bank

Company G-M-R Oil

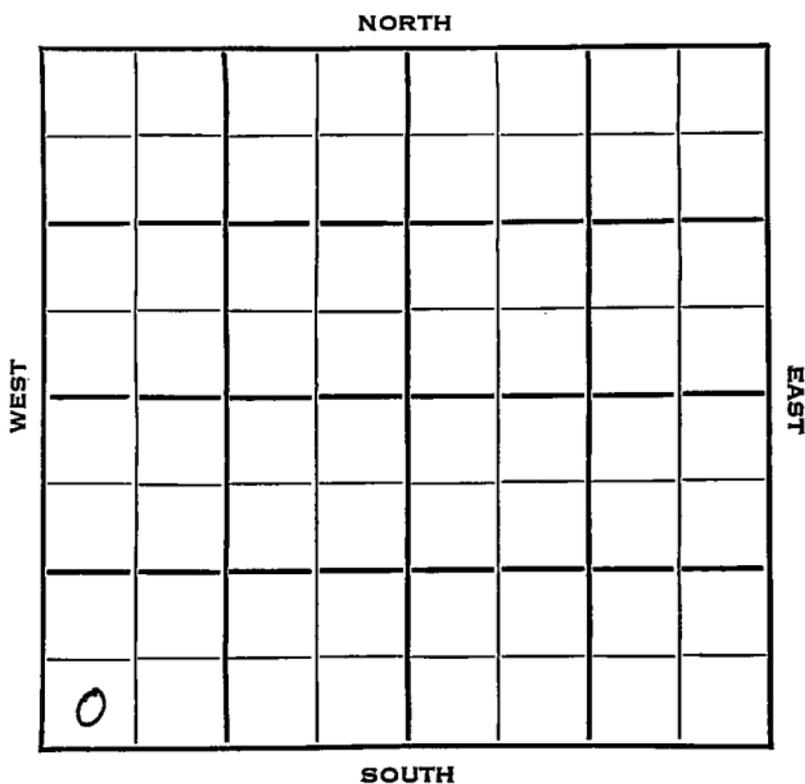

Ellis

KANSAS

SEC.

TWP.

R.

31

11

16W

WELL NO.

#2 Planters St. Bank

COMPANY

FARM

G-M-R Oil

CONTRACTOR

Bemis-Shutts Pool

NORTH

Ft. from N. Line


Ft. from S. Line

Ft. from E. Line

Ft. from W. Line

WEST

EAST

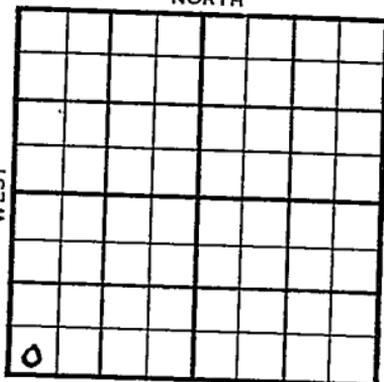

SOUTH

SW SW SW

1953

ELEVATION

2086'

REPORT

1/6

D & A

TD 3650'

8" @ 195'

Anhy 1250', Heeb 3258', Tor 3278'

KC 3306'

DST 3280'-3311' opn 1 hr, rec 77' sw 1100#

DST 3330'-51' opn 1 hr, rec 10' Mud

B KC 3541', Cong 3580'

TD 3650'

D & A

FIRST REPORT

ABANDONED


County Ellis State Kansas

Sec. 31 (Blk. Twp.) 11 (Sur. Rge.) 16W Map No.

Operator G-M-R Oil

Well No. 2 Farm Planters St. Bank

Elev. 2086 Location SW SW SW

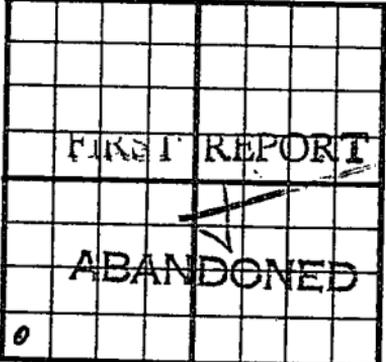

330 Ft. From S Line SW

330 Ft. From W Line Quarter

Ist. Report JAN 6 1954

Completion JAN 6 1954

Remarks Bemis-Shutts Pool

Spudding Date

Drig. Data D & A TD 3650

8" @ 195 Anhy 1250 Heeb. 3258

Tor. 3278 KC 3306 DST 3280-3311

open 1 hr. Rec. 77' sw 1100#

DST 3330-51 open 1 hr. Rec. 10' mud

B KC 3541 Cong. 3580 TD 3650

D & A