


Section 31 Township 11 Range 18 W

Well No. # 1 Johnson

Company Murfin Drlg. et al

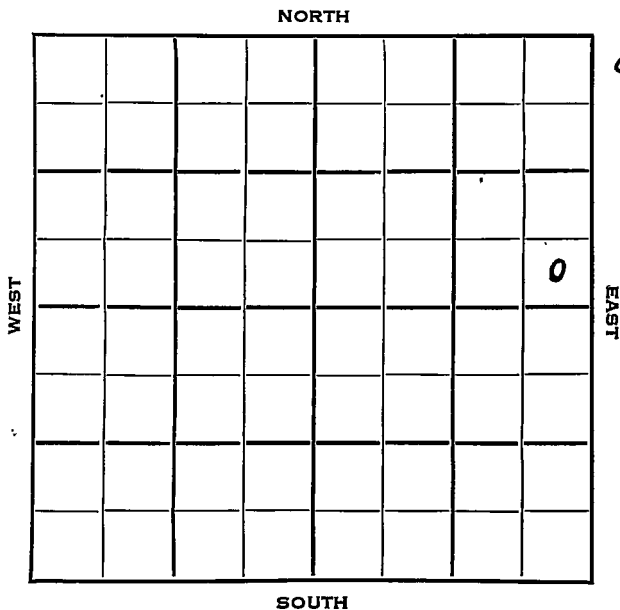

Ellis

KANSAS

SEC.	TWP.	R.
31	11	18W

WELL NO.

#1 Johnson

FARM

COMPANY

Murfin Drlg. et al

CONTRACTOR


Murfin Drlg.

_____ Ft. from N. Line

330 _____ Ft. from S. Line

330 _____ Ft. from E. Line

_____ Ft. from W. Line

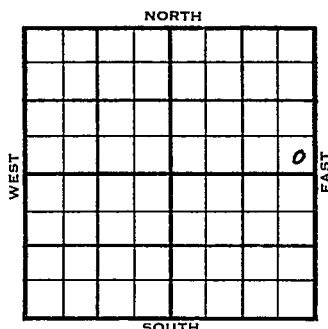


SE SE NE

Shell F/O

	ELEVATION	REPORT
1953	2089'	
10/21	Spud 10-16-53 8" @ 188' Anhy 1395' Drlg 2261'	
10/28	Spud 10-16-53 D&A TD 3720' 8" @ 188' Anhy 1395', Heeb 3332', Tor 3352', Lans 3377' DST 3421-33, opn 1 hr., rec. 630' sw 1125# Simp 3656, Arb. 3667' TD 3720 D&A	
ABANDONED		

County Ellis State Kansas
 Sec. 31 (Blk.) 11 (Sur.) 18W Map No. 11
 Operator Murfin Drlg. et al.
 Well No. 1 Farm Johnson
 Elev. 0 Location SE SE NE

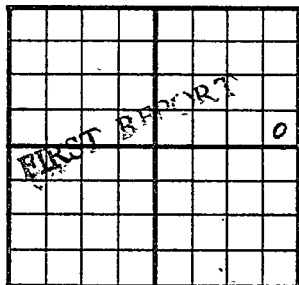

330 Ft. From S Line NE
330 Ft. From E Line Quarter
 Ist. Report Oct 21 1953
 Completion
 Remarks Shell farmout
Murfin Drlg. - Contr.
 Spudding Date 10-16-53

Drlg. Data

8th @ 188 Anhy 1395 drlg. 2261

J. G. McGEHEE

J. G. McGEHEE