


Section 31 Township 11 Range 17W

Well No. 15 Marshall

Company Lario O & Gas

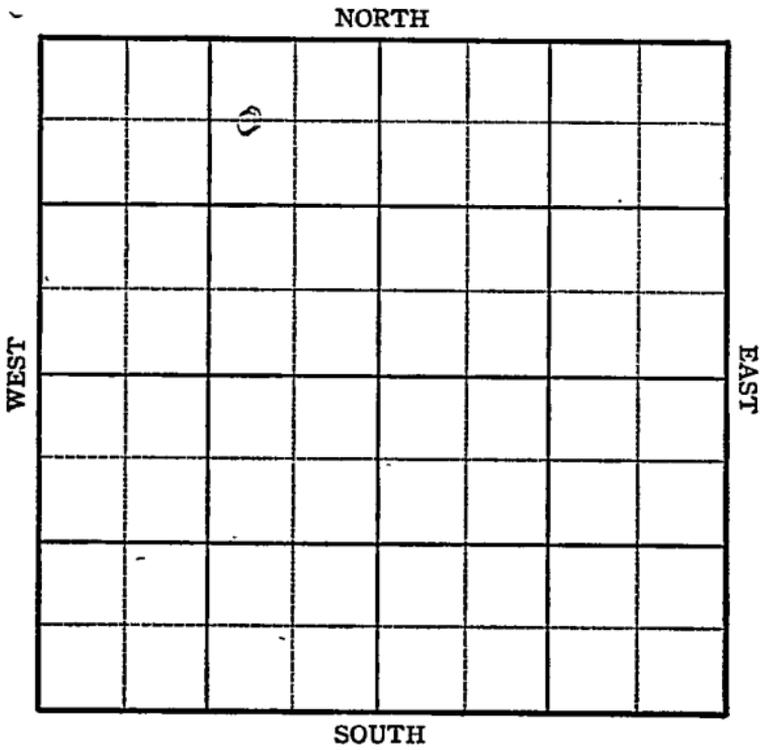

Sec. 31 Twp. 11 R. 17-W


Well No. #15 Marshall Farm  
Lario O& Gas Company

660 Ft. from N. Line

\_\_\_\_\_ Ft. from S. Line

990 Ft. from E. Line

\_\_\_\_\_ Ft. from W. Line

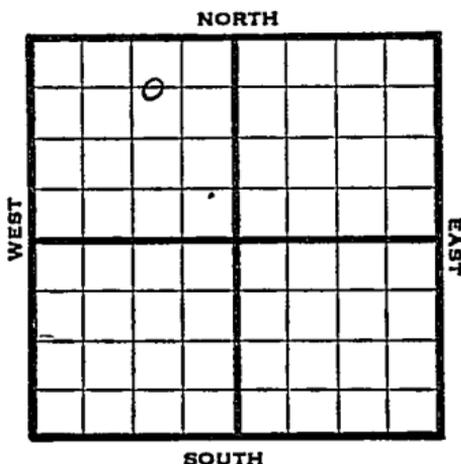

C W L NE NW

1945 Elev. 2120 REPORT

11/14 Location

11/21 Drlg. 1400'

11/28 8" @ 1360

Drlg. 2437'

12/5 Drlg. 3215'

12/12 Arb. 3667

TD 3694'

**ABANDONED**

Pool Name Berris

Kansas

Map No. NSAS Sec. 31 Twp. 11 R. 17WWell No. 15 MarshallLario O & Gas Company

## FIRST REPORT

Contractor

C W L NE NW

## SECTION PLAT

	0		

660 Ft. from N. Line       Ft. from S. Line990 Ft. from E. Line       Ft. from W. Line

Ellis County

Location XRig up       Drilling and Remarks:       

## RECORD

Cased        in.,        ft.Sand       Gas       Oil       Total Depth       

## PRODUCTION

1st 24 hrs. Nat.       1st 24 hrs. after shot       Gas        Cu. Ft.Dry Hole       Abandoned       

Date

NOV 14 1945

19

S. J. LEWIS

Scout

