


Section 31 Township 11 Range 17W

Well No. 19 Marshall "A"

Company Lario Oil & Gas

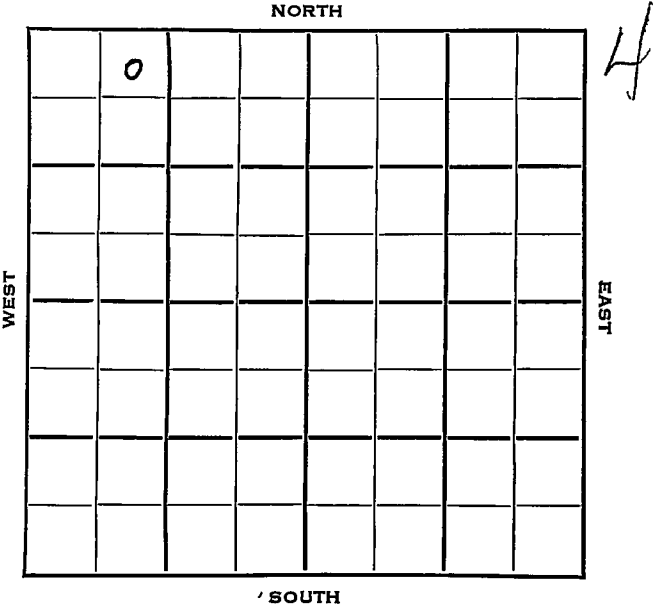

Ellis

KANSAS

|      |      |        |
|------|------|--------|
| SEC. | TWP. | R.     |
| 31   | 11   | 17 W ✓ |

WELL NO.

# 19 Marshall "A"

FARM

COMPANY

Lario Oil &amp; Gas

CONTRACTOR

Walters Drlg.

Bemis-Shutts Pool


330 \_\_\_\_\_ Ft. from N. Line

\_\_\_\_\_ Ft. from S. Line

\_\_\_\_\_ Ft. from E. Line

990 \_\_\_\_\_ Ft. from W. Line

NE NW NW

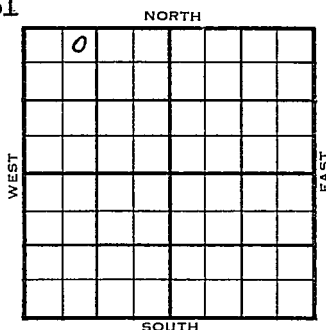

1954

ELEVATION

2088'

REPORT

1/13

MIM

1/20

Anhy 1335'

8" @ 1340'

Drlg. 2650'

2/3

Spud 1-11-54 Oil well TD 3625

Anhy 1335 8" @ 1340 Top 3050

Heeb 3283 Tor 3301

DST 3289-3315 open 1 hr rec 4' gassy  
oil, 26' 0 & GCM, 50' SW 1400#

Lans. 3320

DST 3357-65 open 1 hr rec 60' SOCM,  
60' SW, Cong. 3579 Simp 3589

Arb. 3614 TD 3625 5" @ 3621

CO to 3625 FU 500' oil 1 hr.

S/8 BOPH 6 hr.

Comp. 50 BOPD

**COMPLETED**

County Ellis State Kansas  
 Sec. 31 (Blk.) 11 (Sur.) 17W Map No.  
 Operator Lario Oil & Gas  
 Well No. 19 Farm Marshall "A"  
 Elev. \_\_\_\_\_ Location NE NW NW

|   |  |  |  |  |  |  |  |
|---|--|--|--|--|--|--|--|
| 0 |  |  |  |  |  |  |  |
|   |  |  |  |  |  |  |  |
|   |  |  |  |  |  |  |  |
330 Ft. From N Line NW  
990 Ft. From W Line Quarter  
 1st. Report JAN 13 1954

Completion \_\_\_\_\_

Remarks \_\_\_\_\_

Walters Drig. - Contr.

Spudding Date \_\_\_\_\_

Drlg. Data Bemis-Shutts Pool

MIN

County Ellis State Kansas  
 Sec. 31 (Blk.) 11 (Sur.) 17W Map No.

Operator- Lario Oil & Gas

Well No. 19 Farm Marshall "A"

Elev. 2088 Location NE NW NW

|   |  |  |  |  |  |  |
|---|--|--|--|--|--|--|
| • |  |  |  |  |  |  |
|   |  |  |  |  |  |  |
|   |  |  |  |  |  |  |
330Ft. From N Line NW

990Ft. From W Line Quarter

1st. Report

Completion FEB 3 1954

Remarks Bemis-Shutts Pool

Walters Drlg. - Contr.

Spudding Date 1-11-54

Drlg. Data Oil well TD 3625

Anhy 1335 8" @ 1340 Top. 3050

Heeb. 3283 Tor. 3301 DST 3289-3315

open 1 hr. Rec. 4' gassy oil 26' o & gcm

50' sw 1400# Lans. 3320 DST 3357-65

open 1 hr. Rec. 60' socm 60' sw

Cong. 3579 Simp. 3589 Arb. 3614

TD 3625 5" @ 3621 CO to 3625

FU 500' oil 1 hr. S/ 8" boph 6 hr.

Comp. 50' boph

G. McGEHEE