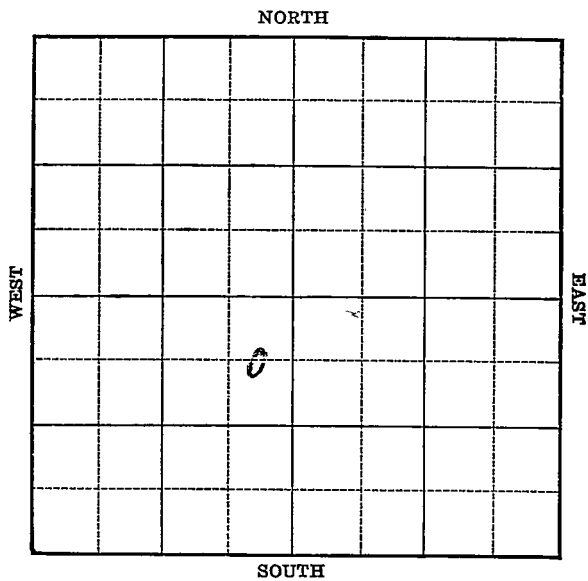


Section 31 Township 11 Range 17WWell No. #8 Marshall RanchCompany Lario Oil & Gas

Map No. 71 Sec. 31 Twp. 11 R. 17WWell No. 8 Marshall RanchLario Oil & Gas

Company

Contractor

FIRST REPORT

C E L NE SW

660 Ft. from N. Line Ft. from S. Line330 Ft. from E. Line Ft. from W. Line

SECTION PLAT

BEMIS POOL

Location Rig up

Drilling and Remarks:

Derrick

RECORD

Cased in., ft.Sand Gas Oil Total Depth

PRODUCTION

1st 24 hrs. Nat. 1st 24 hrs. after shot Gas Cu. Ft.Dry Hole Abandoned

Date

JUL 2 1940 19S. J. LEWIS Scout

Map No. 71 Sec. 31 Twp. 11 R. 17WWell No. 8 Marshall RanchLario Oil & Gas

Company

Contractor

COMPLETED

C E L NE SW

660 Ft. from N. Line Ft. from S. Line330 Ft. from E. Line Ft. from W. Line**SECTION PLAT**

BEMIS POOLLocation Rig up

Drilling and Remarks:

*See 8.3644**5" @ 3645'**4000 acid**Echometer P & Y**2564***RECORD**Cased in., ft.Sand Gas Oil Total Depth 3668'**PRODUCTION**1st 24 hrs. Nat. 1st 24 hrs. after shot Gas Cu. Ft.Dry Hole Abandoned

Date

AUG 7 1940 19S. J. LEWIS Scout