

KANSAS


Ellis

31

Section 31 Township 11 Range 17WWell No. #6 Hadley "B"Company Republic Natural Gas

Bemis Pool NORTH

WEST

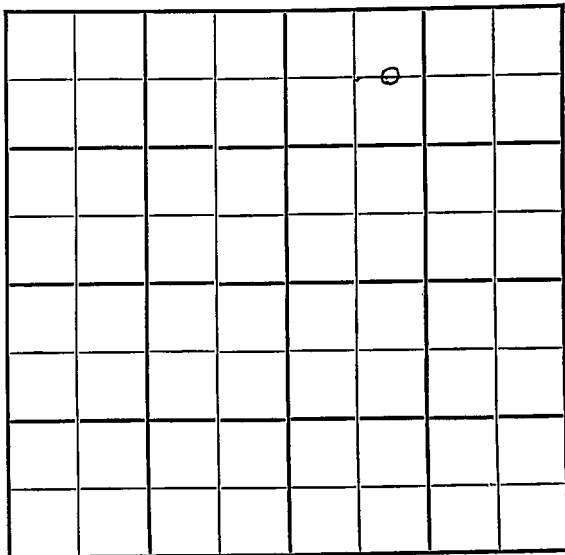

EAST


SOUTH

Sec. 31 Twp. 11 R. 17WWell No. #6 Hadley "B" FarmRepublic Natural Gas Company

Bemis

660 Ft. from N. Line Ft. from S. Line Ft. from E. Line990 Ft. from W. Line

C E L NW NE

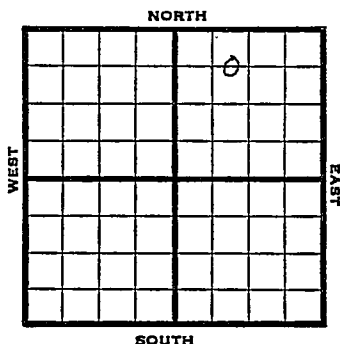

1948

Eli 2099' REPORT

4/14	Location
4/21	425 Run 10"
4/28	"
5/5	10" @ 425' Lansing 3448' Arbuckle 3628' TD 3638' 5" @ 3631' RUST
5/12	"
5/19	"
5/26	TD 3638' Swb 4½ bbls oil PH
6/1	"
6/9	"
6/16	"
6/23	Pump 5½ bbls oil PH
6/29	"
8/14	TD 3638' Arb. 3628' 5" @ 3631' Pump 89 Oil Pot 38° Gr. Comp

COMPLETED

Map No. _____ Sec. 31 Twp. 11 R. 17W

Well No. 6 Hadley "B"

Republic Natural Gas Company

FIRST REPORT Contractor

C E L NW NE


SECTION PLAT

660 Ft. from N. Line

_____ Ft. from S. Line

_____ Ft. from E. Line

990 Ft. from W. Line

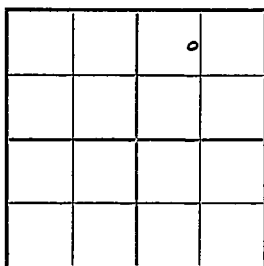

Ellis County

Location X

Rig up _____

Drilling and Remarks:

RECORD

Cased _____ in., _____ ft.

Sand _____

Gas _____

Oil _____

Total Depth _____

PRODUCTION

1st 24 hrs. Nat. _____

1st 24 hrs. after shot _____

Gas _____ Cu. Ft.

Dry Hole _____

Abandoned _____

Date

APR 14 1948 19 S. J. LEWIS Scout

Map No. 71 Sec. 31 Twp. 11 R. 17WWell No. 6 Hadley "B"Republic Natural Gas Company

COMPLETE

C E L NW NE

Contractor

E. 2099

SECTION PLAT

660 Ft. from N. Line Ft. from S. Line Ft. from E. Line990 Ft. from W. Line

Ellis County

Location Rig up

Drilling and Remarks:


RECORD

Cased in., ft.Sand Gas Oil ✓Total Depth 3638

PRODUCTION

1st 24 hrs. Nat. 1st 24 hrs. after shot Gas Cu. Ft.Dry Hole Abandoned

Date

JUL 14 1948

19

S. J. LEWIS

Scout