

# KANSAS

Form 51-5M-7-40-Palace


Ellis

Section 31 Township 11 Range 17-W

Well No. #3 Hadley

Company Amerada & Republic

Bemis pool

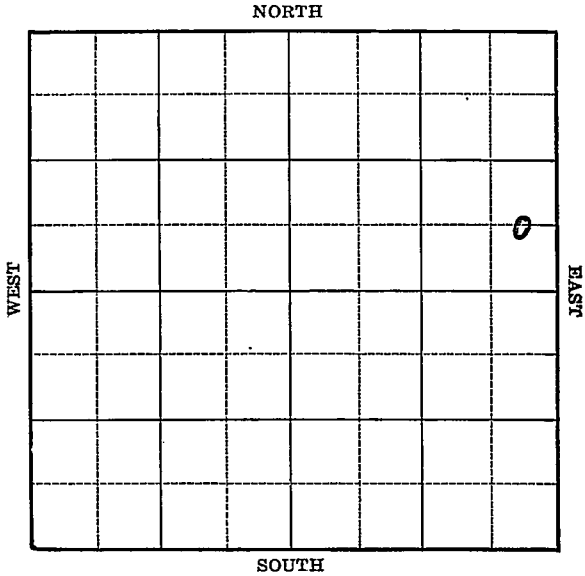



1941  
4/30

Arb. 3641'  
5" - 3642'

T.D. 3654'  
2500 acid.

Potential 143 bbls., pump.  
33.5 Gravity

COMPLETED



Misc Small	<i>RAY</i>
Cards	<i>RAY</i>
Tracing	<i>Joe</i>
Francis Dep	<i>RAY</i>
Scarce	<i>RAY</i>
Moody	<i>Joe</i>
Ce logis	<i>RAY</i>
Wood	<i>RAY</i>

Map No. 71 Sec. 31 Twp. 11 R. 17W

Well No. 3 Hadley

Amerada & Republic Company

Contractor

**COMPLETED**

C E L S E N E

\_\_\_\_\_ Ft. from N. Line

660 Ft. from S. Line

330 Ft. from E. Line

\_\_\_\_\_ Ft. from W. Line

**SECTION PLAT**


BEMIS POOL

Location \_\_\_\_\_

Rig up \_\_\_\_\_

Drilling and Remarks:

*Cor 88641*

*5" @ 8642*

*2500 acid*

*Pump 143 P.T.*

*335 Gr.*

**RECORD**

Cased \_\_\_\_\_ in., \_\_\_\_\_ ft.

Sand \_\_\_\_\_

Gas \_\_\_\_\_

Oil \_\_\_\_\_

Total Depth 3654

**PRODUCTION**

1st 24 hrs. Nat. \_\_\_\_\_

1st 24 hrs. after shot \_\_\_\_\_

Gas \_\_\_\_\_ Cu. Ft.

Dry Hole \_\_\_\_\_

Abandoned \_\_\_\_\_

Date

APR 30 1941

19

S. J. LEWIS Scout

Misc. Small Maps *AAA*  
Cards *AAA*  
Tracing *AAA*  
France Map *AAA*  
Scarborough Map *AAA*  
Moody Map *AAA*  
Geological Dept. ....  
Moody Flat Book .....