

# KANSAS

Ellis

Form 51-5M-7-39-Palace


Section 31 Township 11 Range 17-W

Well No. #2 Hadley

Company Amerada et al

Burnett Pool

NORTH

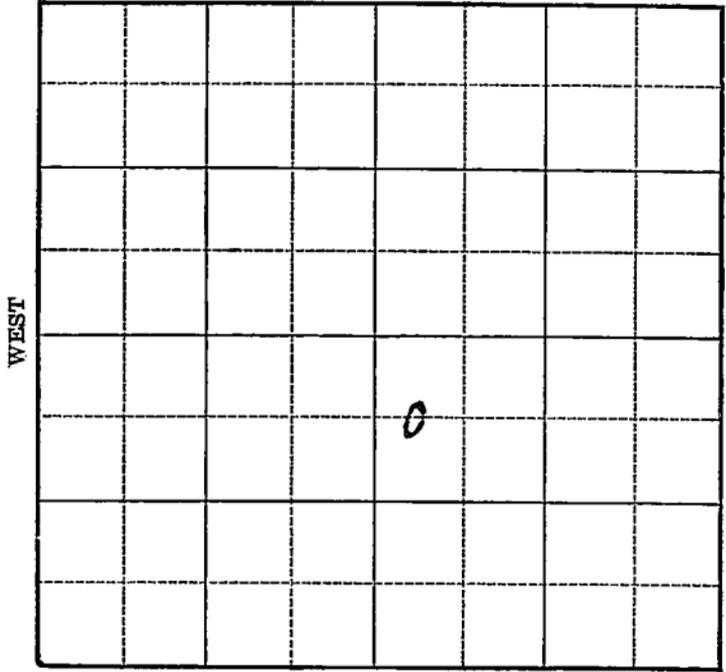

SOUTH

Sec. 31 Twp. 11 R. 17-W

Well No. #2 Hadley Farm \_\_\_\_\_

Amerada et al Company \_\_\_\_\_

(Burnett)


660 Ft. from N. Line

\_\_\_\_\_ Ft. from S. Line

\_\_\_\_\_ Ft. from E. Line

330 Ft. from W. Line

**Elev. 2117**

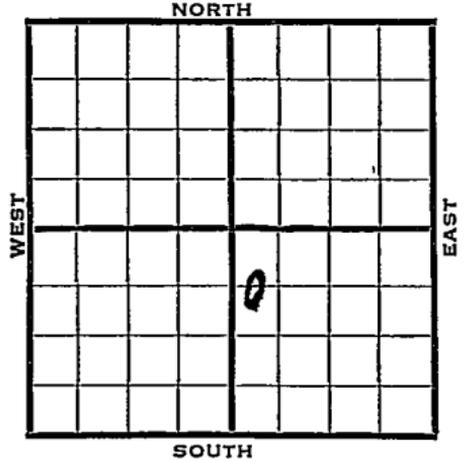

1940	REPORT
5/22	Derrick.
5/29	T.D. 1112' 9" stuck @ 709' Circulating.
6/6	Anhy 1354' 9" - 1085' Drlg. 2644'
6/13	Topeka 3085' Lans. 3367' Drlg. 3512'
6/20	Arb. 3657' 5" - 3657' T.D. 3663' RUST.
6/27	T.D. 3663' 500 acid. Swab 194 bbls. in 6 hours.
7/2	Arb. 3657' 5" - 3658' T.D. 3663' 500 acid. Echometer potential 1197 bbls.
<b>COMPLETED</b>	

Map No. 71 Sec. 31 Twp. 11 R. 17WWell No. 2 HadleyAmerada etal

Company

Contractor

## FIRST REPORT

C W L NW SE

660 Ft. from N. Line

\_\_\_\_\_ Ft. from S. Line

\_\_\_\_\_ Ft. from E. Line

330 Ft. from W. Line

BURNETT POOL

## SECTION PLAT

		o	

Location \_\_\_\_\_

Rig up \_\_\_\_\_

Drilling and Remarks:

Derrick

## RECORD

Cased \_\_\_\_\_ in., \_\_\_\_\_ ft.

Sand \_\_\_\_\_

Gas \_\_\_\_\_

Oil \_\_\_\_\_

Total Depth \_\_\_\_\_

## PRODUCTION

1st 24 hrs. Nat. \_\_\_\_\_

1st 24 hrs. after shot \_\_\_\_\_

Gas \_\_\_\_\_ Cu. Ft.

Dry Hole \_\_\_\_\_

Abandoned \_\_\_\_\_

Date

MAY 22 1940

19

S. J. LEWIS

Scout

Map No. 71 Sec. 31 Twp. 11 R. 17W

Well No. 2 Hadley

Amerada etal Company

Contractor

**COMPLETED**

C W L NW NE

660 Ft. from N. Line

\_\_\_\_\_ Ft. from S. Line

\_\_\_\_\_ Ft. from E. Line

330 Ft. from W. Line

**SECTION PLAT**

		0	

**BURNETT POOL**

Location \_\_\_\_\_

Rig up \_\_\_\_\_

Drilling and Remarks:

*Cor & 3657*  
*5" @ 3658.*  
*500 acid*  
*Echometer*  
*1197*

**RECORD**

Cased \_\_\_\_\_ in., \_\_\_\_\_ ft.

Sand \_\_\_\_\_

Gas \_\_\_\_\_

Oil \_\_\_\_\_

Total Depth 3663

**PRODUCTION**

1st 24 hrs. Nat. \_\_\_\_\_

1st 24 hrs. after shot \_\_\_\_\_

Gas \_\_\_\_\_ Cu. Ft.

Dry Hole \_\_\_\_\_

Abandoned \_\_\_\_\_

Date

JUL 2 1940

S. J. LEWIS Scout