


Section 31 Township 11 Range 17W

Well No. 1 Hadley "C"

Company Walters Drlg.

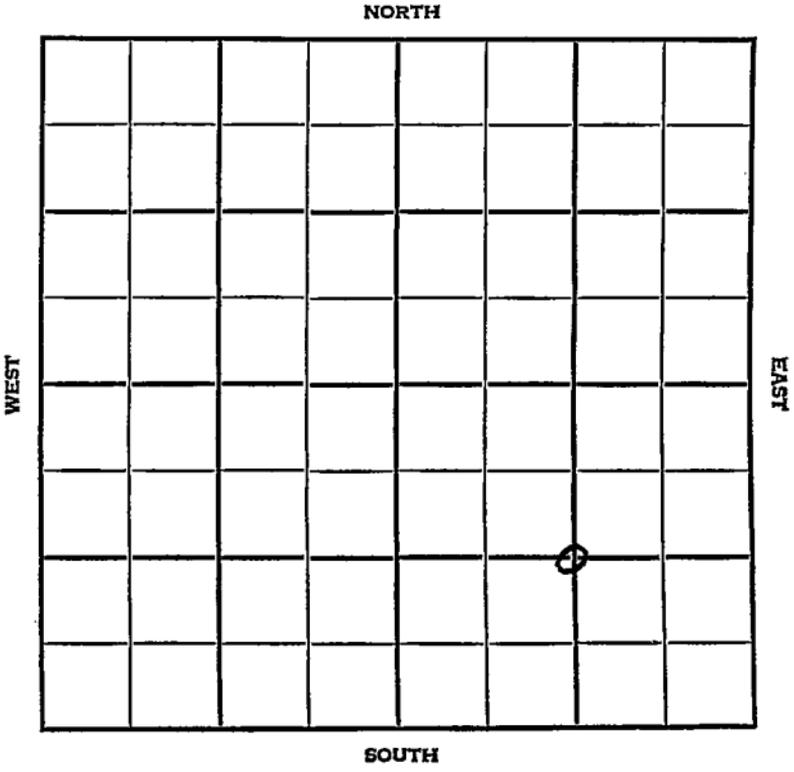

Ellis

KANSAS

SEC.	TWP.	R.
31	11	17 W

WELL NO.

# 1 Hadley "C"

FARM

COMPANY

Walters Drlg.

CONTRACTOR

Co. Tools.

Bemis Pool


\_\_\_\_\_ Ft. from N. Line

1320 \_\_\_\_\_ Ft. from S. Line

1320 \_\_\_\_\_ Ft. from E. Line

\_\_\_\_\_ Ft. from W. Line

C SE/4

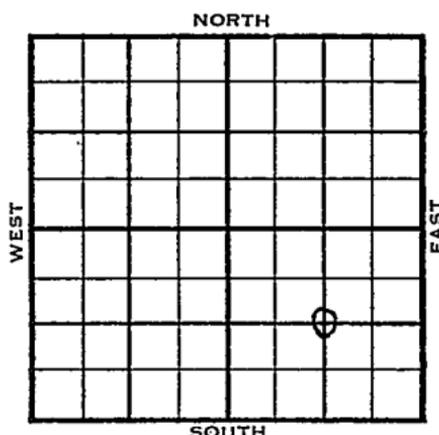

1954

ELEVATION  
2111'

REPORT

10/6

Spud 10-2-54

8" @ 176

Drlg. 413'

11/3

Spud 10-2-54

D &amp; A

TD 3667'

8" @ 176'

Anhy 1356', Top 3087', Heeb 3318'

Lans 3367'

DST 3450'-66' opn  $\frac{1}{2}$  hr, rec 5' Mud 50#

Cong 3611', Simp 3634', Arb 3657'

DST 3658'-3662' opn  $1\frac{1}{2}$  hr, rec 80' ocm  
1160#

TD 3662'

5 $\frac{1}{2}$ " @ 3658'

CO to 3662'

B/ 30 goph 2 hr. 500 A B/ 62 gf

45% Wtr. 1 hr. DD 3667'

D &amp; A

ABANDONED



County Ellis State Kansas

Sec. 31 (Blk. 11) (Sur. 17W) (Twp. 11) (Rge. 17W) Map No.

Operator Walters Drlg.

Well No. 1 Farm Hadley "C"

Elev. 2111 Location C SE/4


1320 Ft. From S Line SE

1320 Ft. From E Line Quarter

1st. Report

Completion NOV 3 1954

Remarks Bemis Pool

Co. tools

Spudding Date 10-2-54

Drlg. Data D & A TD 3667

8" @ 176 Anhy 1356 Top. 3087

Heeb. 3318 Lans. 3367 DST 3450-66

open 1/2 hr. Rec. 5' mud 50# Cong. 3611

Simp. 3634 Arb. 3657 DST 3658-3662

open 1 1/2 hr. Rec. 80' ocm 1160#

TD 3662 5 1/2" @ 3658 CO to 3662

B/ 30 goph 2 hr. 500 A B/ 62 gf

45% water 1 hr. DD 3667

D & A