


Section 31 Township 11 Range 20 W

Well No. #3 J. Huck "A"

Company Stanolind

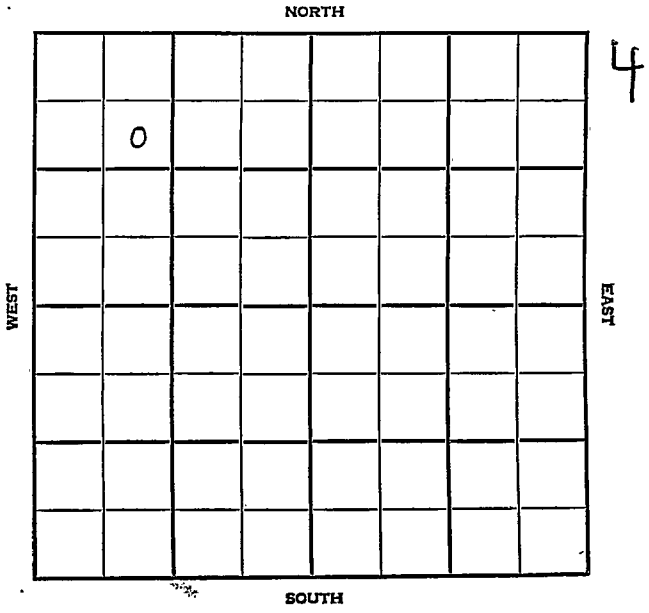

Ellis

KANSAS


SEC.	31	TWP.	11	R.	20W
------	----	------	----	----	-----

WELL NO. #3 J. Huck "A" FARM

COMPANY Stanolind

CONTRACTOR Transit

Nicholson	
Ft. from N. Line	
Ft. from S. Line	
Ft. from E. Line	
Ft. from W. Line	
SE NW NW	

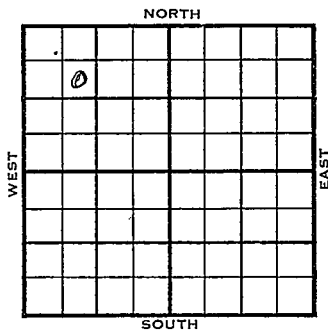

1956	ELEVATION	REPORT
	2257	

2-22 Location

3-21 Comm. 2-21-56
 8 5/8" @ 207/150
 5 1/2" @ 3844/15
 CO to 3848
 S/ 2 boph 4 hrs., 500 A
 S/ 3 1/2 boph 8 hrs.
 Comp. 5 1/4 bopd
 Anh. 1656
 L. 3535
 A 3839
 TD 3848

COMPLETED

County ELVIS Elev. _____
 Sec. 31 Twp. 11 Rge. 20W
 Company Stanolind
 Farm Name J. Huck "A" No. 3

TOPS	DEPTH	LOG	DATUM
Anh.			
TP.			
H.			
Tr.			
Dg.			
Bl.			
L.			
K.C.			
B.K.C.			
Ce.			
C.			
M.			
M.			
K.			
Mz.			
Me.			
V.			
S.			
S.			
A.			
R.			
PE.			
G.			
T.D.			

Loc. in Sec. SE NW NW

Geol. _____
 Contr. Transit

Pool Nicholson

FIRST REPORT
 FEB 22 '56

Date Comm. _____
 Location _____

~~31~~

Co.
 Sec.
 T.
 R.

County Ellis Elev. 2257
 Sec. 31 Twp. 11 Rge. 20W
 Company Stanolind
 FarmName J. Huck "A" No. 3

TOPS	DEPTH	LOG	DATUM	Loc. in Sec.																																
Anh.	<u>1656</u>			SE NW NW																																
Tr.																																				
H.																																				
Tr.																																				
Dg.																																				
Bl.																																				
L.	<u>3535</u>		<u>1278</u>	Geol.																																
K.C.				Contr.																																
B.K.C.				Transit																																
Ce.																																				
C.				Pool																																
M.				Nicholson																																
M.				<table border="1"> <tr><td></td><td></td><td></td><td></td></tr> <tr><td></td><td></td><td></td><td></td></tr> <tr><td></td><td></td><td></td><td></td></tr> <tr><td></td><td></td><td></td><td></td></tr> <tr><td></td><td></td><td></td><td></td></tr> <tr><td></td><td></td><td></td><td></td></tr> <tr><td></td><td></td><td></td><td></td></tr> <tr><td></td><td></td><td></td><td></td></tr> </table>																																
K.																																				
Mz.																																				
Me.																																				
V.																																				
S.																																				
S.																																				
A.	<u>3839</u>		<u>1582</u>																																	
R.																																				
Pe.																																				
G.																																				
T.D.	<u>3848</u>																																			

Date Comm. 2-21-56 MAR 21 1956

8 5/8" @ 207/150 5 1/2" @ 3844/15

CO to 3848 S/ 2 boph 4 hr. 500 A

S/ 3 1/2 boph 8 hr. Comp. 5 1/4 bopd

Co.
Lse.
No.
Sec.
T.
R.