


Section 31 Township 11 Range 20W

Well No. #1 Caskey "SWD"

Company Skelly Oil Co.

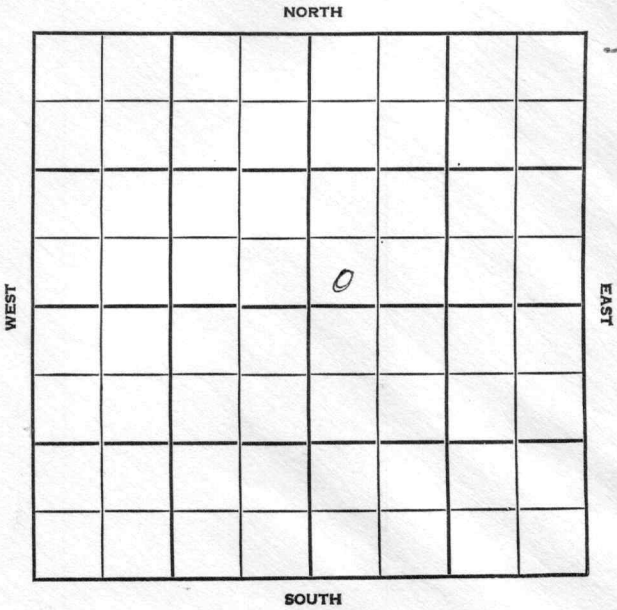

County Ellis Elev. 2231 DF
 Sec. 31 Twp. 11 Rge. 20W
 Company Skelly Oil Co.
 Farm Name Caskey "SWD" No. 1

TOPS	DEPTH	LOG	DATUM	Loc. in Sec.
Anh.	<u>3833</u>			<u>SW SW NE</u>
Tp.				
H.				
Tr.				
Dg.				
Bl.				
L.				Geol.
K.C.				Contr.
B.K.C.				
Ce.				
C.				
M.				Pool
M.				<u>Nicholson</u>
K.				
Mz.				
Ma.				
V.				
S.				
S.				FIRST REPORT
A.				<u>0</u>
R.				SEP 19 '56
Pe.				COMPLETE
G.				
T.D.	<u>3858</u>	<u>3992</u>		

Date Comm.

5" @ 3834, DD 3917, ran 207' of 4" perf liner,
lost bit, PB 3962, 3000 acid - took 178 BW in
18 min by grav. COMPLETE SEP 26 '56

R.G.