


Section 31 Township 11 Range 20W

Well No. 1 J. F. Huck #Bn

Company Stanolind

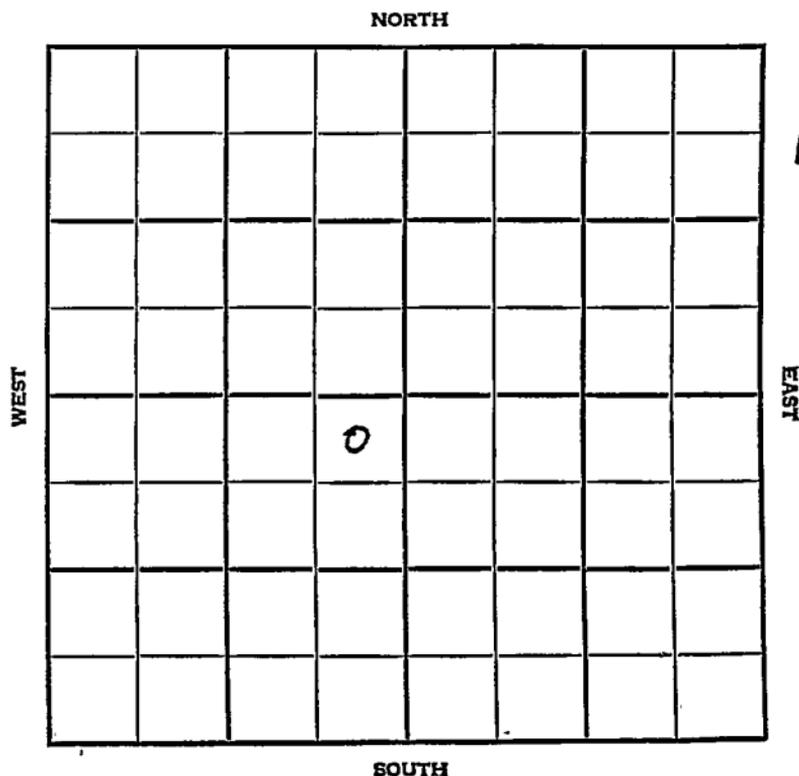

Ellis KANSAS

SEC.	TWP.	R.
31	11	20W

WELL NO. 1 J. F. Huck "BBH" FARM

COMPANY Stanolind

CONTRACTOR Transit


S. Nicholson Pool

330 Ft. from N. Line

Ft. from S. Line

330 Ft. from E. Line

Ft. from W. Line

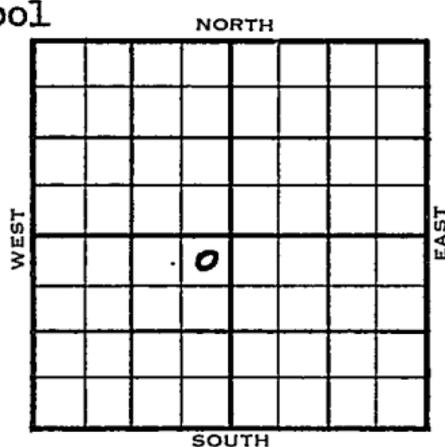

NE NE SW

1954	ELEVATION 2253'	REPORT
------	-----------------	--------

~~7/14~~  
~~2/17/54~~


Spd 7-11-54  
8" @ 196  
Anhy 1670  
Drlg. 1675

8/4

Spud 7-11-54 - Oil Well  
TD 3853'  
8" @ 196'  
Anhy 1670', Lans 3530', Arb. 3840'  
TD 3853'  
5" @ 3848'  
CO to 3853'  
B/2 1/2 boph 500A  
DST 3840-50', opn 1 hr., rec. 100'  
ocm, 610#  
S/5 1/2 BOPH 7 hrs.  
Comp. 104 bopd

COMPLETED

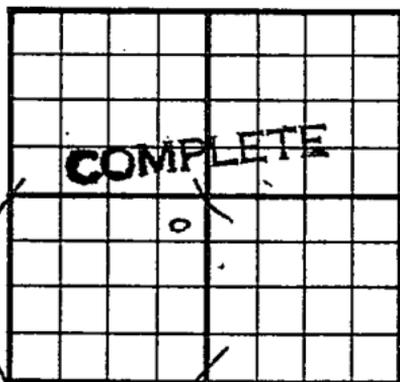

County Ellis State KansasSec. 31 (Blk.  
Twp.) 11 (Sur.  
Rge.) 20W Map No.Operator StanolindWell No. 1 Farm J. G. Huck "B"Elev. 2253 Location NE NE SW330 Ft. From N Line SW330 Ft. From E Line Quarter

1st. Report

Completion AUG 4 1954Remarks S. Nicholson PoolTransit - Contr.Spudding Date 7-11-54Drlg. Data Oil well TD 38538" @ 196 Anhy 1670 Lans. 3530Arb. 3840 TD 3853 5" @ 3848 CO to 3853B/ 2 $\frac{1}{2}$  boph 500 A DST 3840-50 open 1 hrRec. 100' ocm 610# S/ 5 $\frac{1}{2}$  boph 7 hr.Comp. 104 bopd

J. G. McGEHEE