


DX 78-1 Ellis

KANSAS

Section 31 Township 11 Range 20W

Well No. #2 J. L. Caskey

Company Skelly Oil

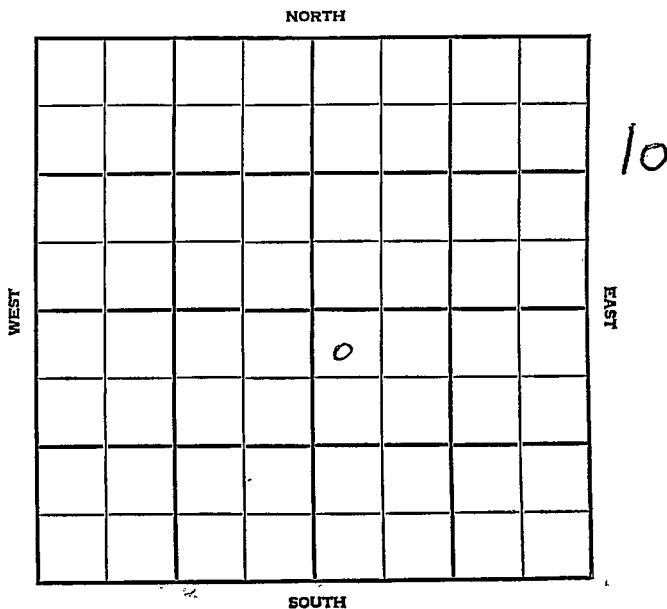

Ellis KANSAS

SEC.	TWP.	R.
31	1E	20W

WELL NO. 2 J. L. Caskey FARM

COMPANY Skelly Oil

CONTRACTOR Wentworth


Nicholson Pool

330 Ft. from N. Line

Ft. from S. Line

Ft. from E. Line

330 Ft. from W. Line

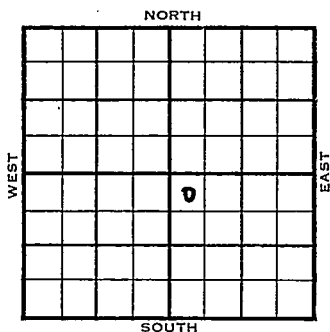

NW NW SE

1954	ELEVATION 2247'	REPORT
------	--------------------	--------

11/3 Spud 10-29-54
8" @ 320'
Drlg. 1800'

11/23 Spud 10-29-54 Oil well TD 3870
8" @ 320 Top 3276 Heeb 3503
Tor. 3524 Lans 3538 Cong. 3829
Simp. 3836 Arb. 3848 TD 3850
5" @ 3849 DD 3860 S/15 GO 5 hr.
DD 3870 3 GOPH 1050 A S/98 BO
13 hr. Comp. 285 BOPD 24 BW

COMPLETED

