

DX 78-1'

KANSAS

Section 31 Township 11 Range 20W

Well No. #4 J.L. Caskey

Company Skelly Oil

NORTH

WEST

0

SOUTH

EAST

Ellis KANSAS

SEC.	TWP.	R.
31	11	20W

WELL NO.

h J. L. Caskey FARM
COMPANY

Skelly Oil
CONTRACTOR

Nicholson Pool


330 Ft. from N. Line

Ft. from S. Line

330 Ft. from E. Line

Ft. from W. Line

NE NE NE

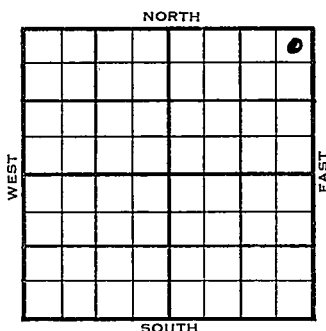

1954

ELEVATION
2231'

REPORT

11/23

Location

12/22

Spud 11-27-54

Oil Well

TD 3839'

8" @ 318'

Top 3265' Heeb 3483' Tor 3505' Lans

3522' Arb. 3835'

TD 3838'

5" @ 3836'

DD 3839'

FU 1300' oil 11 hr. 27/ 3835-38

FU 1500' oil 500 A S/ 41 bo 7 bw.
4 hr.

Comp 331 bopd. 3 bw.

COMPLETED

County **Ellis** State **Kansas**Sec. **31** (Blk.) **11** (Sur.) **20W** Map No.Operator **Skelly Oil**Well No. **4** Farm **J. L. Caskey**Elev. Location **NE NE NE**

330 Ft. From **N** Line **NE****330** Ft. From **E** Line Quarter1st. Report **NUV** **23** 1954


Completion

Remarks

Spudding Date

Drig. Data **Nicholson Pool****Location****FABEN GILSTRAP**

County Ellis State Kansas
 Sec. 31 (Blk. 11 (Sur. 20W Map No.
 (Twp.) (Rge.)
 Operator Skelly Oil
 Well No. 4 Farm J. L. Caskey
 Elev. 2231 Location NE NE NE

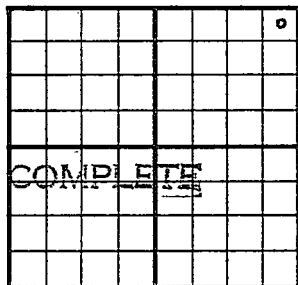

330 Ft. From N Line NE

330 Ft. From E Line Quarter

Ist. Report

Completion DEC 22 1954

Remarks Nicholson Pool

Spudding Date 11-27-54

Drlg. Data Oil well TD 3839

8" @ 318 Top. 3265 Heeb. 3483

Tor. 3505 Lans. 3522 Arb. 3835

TD 3838 5" @ 3836 DD 3839

FU 1300' oil 11 hr. 27/ 3835-38

FU 1500' oil 500 A S/ 41 bo 7 bw

4 hr. Comp. 331 bopd 3 bw

FABEN GILSTRAP