


Section 31 Township 11 Range 20 W

Well No. #2 John Huck "A"

Company Stanolind

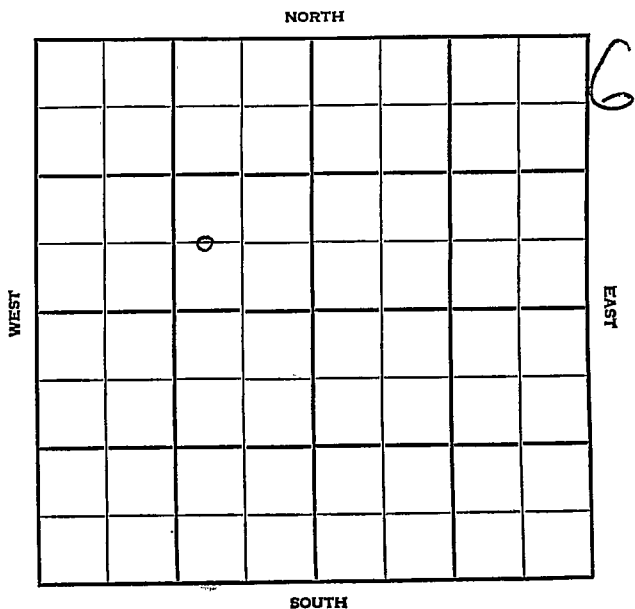


SEC.	TWP.	R.
31	11	20W

WELL NO. #2 John Huck "A" FARM

COMPANY C W<sup>1</sup>/<sub>2</sub> SE NW

CONTRACTOR Transit Nicholson

\_\_\_\_\_ Ft. from N. Line  
 \_\_\_\_\_ Ft. from S. Line  
 \_\_\_\_\_ Ft. from E. Line  
 \_\_\_\_\_ Ft. from W. Line

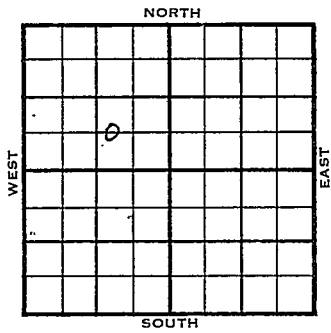

~~E~~ C W<sup>1</sup>/<sub>2</sub> SE NW

1955	ELEVATION	REPORT
	<del>3255</del> 2245'	

10/12 Location

11/9 ~~Comm 9-16-55~~  
~~8 1/2" @ 202/150~~  
~~5 1/2" @ 3913/200~~

11/9 Comm 10-13-55  
 8 5/8" @ 210/150  
 Anh 1633 1654  
 H 3489  
 L 3528 3522  
 A 3828 3828  
 TD 3836

DST 3822-31 open 1 hr rec 5' mud ~~60/2~~  
 60/20" 5 1/2" @ 3829/150 Go to  
 3836 10 goemph 500 A S/1.67  
 boph 15 hr  
 Comp 36 bopd

COMPLETED

County Elvis Elev. \_\_\_\_\_  
 Sec. 31 Twp. 11 Rge. 20W  
 Company Stanolind  
 FarmName John Huck #A<sup>11</sup> No. 2

TOPS	DEPTH	LOG	DATUM	Loc. in Sec.
Anh.				<u>C W<sub>1</sub> SE NW</u>
Tp.				
H.				
Tr.				
Dg.				
Bl.				
L.				Geol. _____
K.C.				Contr _____
B.K.C.				<u>Transit</u>
Ce.				
C.				Pool _____
M.				<u>Nicholson</u>
M.				
K.				
Mz.				
Me.				
V.				
S.				
S.				
A				
R.				
Pe.				
G.				
T.D.				

**FIRST REPORT**  
 OCT 12 1955

Date Comm. \_\_\_\_\_

Location \_\_\_\_\_

\_\_\_\_\_

\_\_\_\_\_

\_\_\_\_\_

\_\_\_\_\_

\_\_\_\_\_

\_\_\_\_\_

\_\_\_\_\_

\_\_\_\_\_

\_\_\_\_\_

\_\_\_\_\_

Co.  
Lse.  
No.  
Sec.  
T.  
R.

County Elvis Elev. 2245  
 Sec. 31 Twp. 11 Rge. 20W  
 Company Stanolind  
 Farm Name John Huck "A" No. 2

TOPS	DEPTH	LOG	DATUM
Anh.	1633	1654	
Tp.			
H.	3489		1244
Tr.			
Dg.			
Bl.			
L.	3528	3522	1277
K.C.			
B.K.C.			
Ce.			
C.			
M.			
M.			
K.			
Mz.			
Mq.			
V.			
S.			
S.			
A	3828	3828	1583
R.			
Pc.			
G.			
T.D.	3836		

Loc. in Sec. C W<sup>1</sup>/<sub>2</sub> SE NW  
 Geol. \_\_\_\_\_  
 Contr. Transit  
 Pool Nicholson  

	0	
<b>COMPLETE</b>		

Date Comm. 10-13-55 NOV 9 1955  
8 5/8" @ 210/150 DST 3822-31  
open 1 hr. rec. 5' mud 60/20"  
5 1/2" @ 3829/150 CO to 3836 : 10 goemph  
500 A S/ 1.67 boph 15 hr.  
Comp. 36 bond

Co. Lse. No. Sec. I. R.