


Section 31 Township 11 Range 20 W

Well No. # 1 J. L. Caskey

Company Skelly Oil Co.

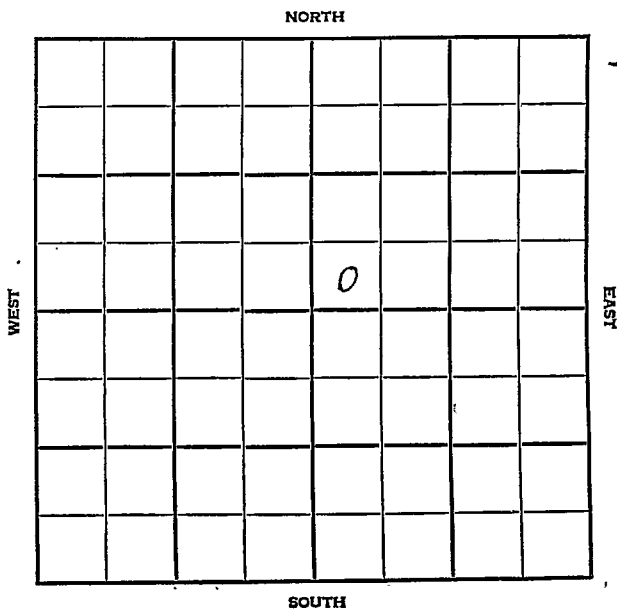

Ellis KANSAS


SEC. 31	TWP. 11	R. 20 W
------------	------------	------------

WELL NO. # 1 J. L. Caskey FARM

COMPANY Skelly Oil Co.

CONTRACTOR Wentworth
S. Nicholson Pool

_____ Ft. from N. Line
330 _____ Ft. from S. Line
_____ Ft. from E. Line
330 _____ Ft. from W. Line

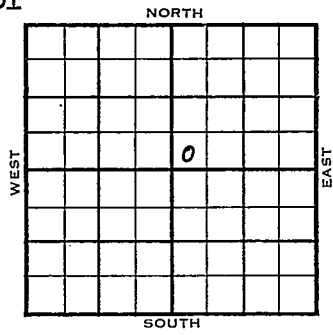

SW SW NE

	ELEVATION	REPORT
1954	2231'	

9/22 Spud 9-19-54
8" @ 301 w/175

10/20 Spud 9-19-54 - Oil Well
TD 3858'
8" @ 301'
Heeb. 3485', Tor 3506', Lans 3521'
DST 3565-97', opn 1/2 hrs., rec. 10'
SOCM, 510#
DST 3598-3612', opn 1/2 hrs., rec. 15'
wtry mud, 870#
Cong. 3815', Simp. 3827', Arb. 3833'
TD 3839'
5" @ 38 34'
DD 3850', 1 goph, DD 3858', 5 goph
300A, S/5 bo 4 hrs., 600A, P/49 bo
6 bw 12 hrs.
Comp. 90 BOPD 9% wtr.

COMPLETED

