
KANSAS Trego County

FORM 51 5M PETROL

Section 31 Township 11 Range 21W

Well No. 1 Murgrave

Company Lauck & Moncrief

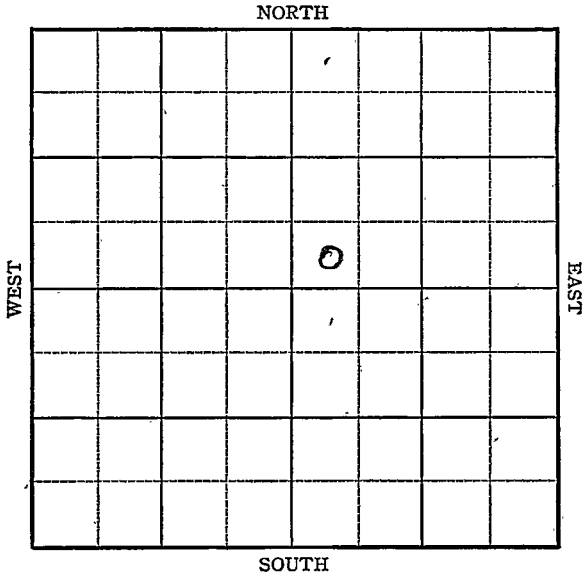

FORM 252-A
5M 3-45 PETROL

KANSAS Trego

Sec. 31 Twp. 11 R. 21W

Well No. 1 Murgrave Farm

Lauck & Moncrief Company

Wildcat


_____ Ft. from N. Line

330 Ft. from S. Line

_____ Ft. from E. Line

330 Ft. from W. Line

SW NE

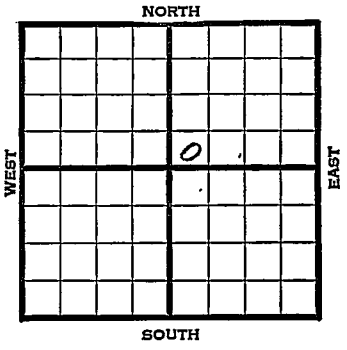

1945	Elev. 2331 REPORT
6/26	Location
7/3	Derrick
7/11	RUR
7/19	Surface hole,
7/26	10" @ 158' WOC
8/8	Lans 3610 Arb. 4024 T.D. 4060'

ABANDONED

FORM 26 200 BKS. 2-44 PETROL

Kansas Pool Name Wildcat

Map No. 70 Sec. 31 Twp. 11 R. 21W


Well No. 1 Murgrave

Lauck & Mondrief Company

FIRST REPORT Contractor

SW NE

SECTION PLAT

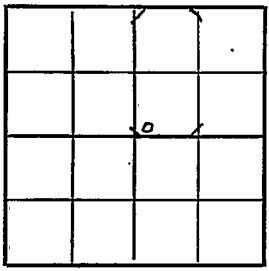

____ Ft. from N. Line

330 Ft. from S. Line

____ Ft. from E. Line

330 Ft. from W. Line

Trego County

Location X

Rig up

Drilling and Remarks:

RECORD

Cased ____ in., ____ ft.

Sand

Gas

Oil

Total Depth

PRODUCTION

1st 24 hrs. Nat.

1st 24 hrs. after shot

Gas ____ Cu. Ft.

Dry Hole

Abandoned

Date

JUN 2 7 1945 19

S. J. LEWIS Scout

FORM 26 200 BKS 1 44 PETROL

Pool Name Wildcat

KANSAS Kansas

Map No. 70 Sec. 31 Twp. 11 R. 21W

Well No. 1 Musgrave


Lauck & Moncrief Company

ABANDONED Contractor

SW NE

E12331

SECTION PLAT.

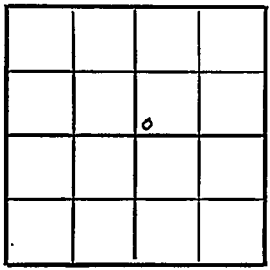

Ft. from N. Line

330 Ft. from S. Line

Ft. from E. Line

330 Ft. from W. Line

Trego County

Location

Rig up

Drilling and Remarks:

Lime 3610

CP 4024

RECORD

Cased in., ft.

Sand

Gas

Oil

Total Depth 4060

PRODUCTION

1st 24 hrs. Nat.

1st 24 hrs. after shot

Gas Cu. Ft.

Dry Hole

Abandoned

Date

AUG 8 1945 19 S. J. LEWIS Scout