

Map No. **KANSAS** Sec. **31** Twp. **11** S R. **38** W
 Well No. **1- Robidoux** Farm
Shas A. Sawyer Company

NORTH

WEST

0							

EAST

SOUTH

Location.....

Drilling Remarks

Rig Up.....

Drilling Remarks

RECORD

Cased.....in.....ft.

Sand.....

Gas.....

Oil.....

Total Depth.....

PRODUCTION

1st 24 hrs. Nat.....

1st 24 hrs. after shot.....

Gas.....cu. ft.....

Dry Hole.....

Abandoned.....

Map No. Sec. Twp. R.

Well No. Farm


..... Company

..... Ft. from N. Line

..... Ft. from S. Line

..... Ft. from E. Line

..... Ft. from W. Line

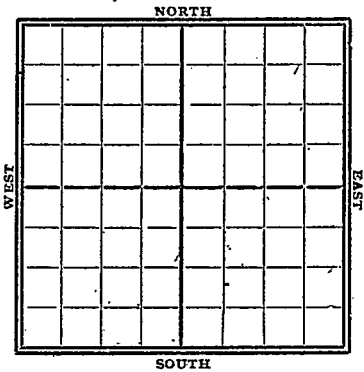

1923

Date

REPORT

Gypsf Records
Ord TD 2450'

MAP No. _____ SEC. 31 TWP. 11S R. 38WWELL No. 1 Rotterdam

Chas. A. Surter COMPANY

CONTRACTOR

No wall map

SECTION PLAT

_____ FT. FROM N. LINE

_____ FT. FROM S. LINE

_____ FT. FROM E. LINE

_____ FT. FROM W. LINE

LOCATION _____

RIG UP _____

DRILLING AND REMARKS:

RECORD

CASED _____ IN. _____ FT.

SAND _____

GAS _____

OIL _____

TOTAL DEPTH 2480

PRODUCTION

1ST 24 HRS. NAT. _____

1ST 24 HRS. AFTER SHOT _____

GAS _____ CU. FT.

DRY HOLE ☒ABANDONED ☒

DATE

Mar 3 1923 SCOUT