

STATE CORPORATION COMMISSION OF KANSAS
OIL & GAS CONSERVATION DIVISION
WELL COMPLETION OR RECOMPLETION FORM
ACO-1 WELL HISTORY
DESCRIPTION OF WELL AND LEASE

Operator: License # 9087
Name R. & C. Drilling, Inc.
Address P. O. Box 296
City/State/Zip Hays, Kansas 67601

Purchaser

Operator Contact Person R. L. Finnesy
Phone 913-625-5891

Contractor: License # 9087
Name R. & C. Drilling, Inc.

Wellsite Geologist Ken Vehige
Phone 913-625-5891

Designate Type of Completion
 New Well Re-Entry Workover
 Oil SWD Temp Abd
 Gas Inj Delayed Comp.
 Dry Other (Core, Water Supply etc.)

If ONWO: old well info as follows:
Operator
Well Name
Comp. Date Old Total Depth

WELL HISTORY

Drilling Method:
 Mud Rotary Air Rotary Cable
3-28-86 4-5-86 4-5-86
Spud Date Date Reached TD Completion Date
4665'
Total Depth PBTD

Amount of Surface Pipe Set and Cemented at 206 feet
Multiple Stage Cementing Collar Used? Yes No
If yes, show depth set...feet
If alternate 2 completion, cement circulated from...feet depth to...w/...SX cmt
Cement Company Name
Invoice #

API NO. 15-663-21024
County Gove
SE NW Sec 1 Twp 11 Rge 31 East
West
4290 Ft North from Southeast Corner of Section
4290 Ft West from Southeast Corner of Section
(Note: Locate well in section plat below)


Lease Name Baalman Well # A-2

Field Name

Producing Formation

Elevation: Ground 2969 2974 KB

Section Plat

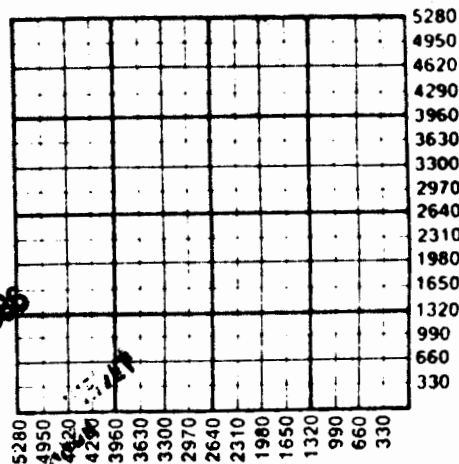

WATER SUPPLY INFORMATION
Disposition of Produced Water: Disposal
Docket # Repressuring

Questions on this portion of the ACO-1 call:
Water Resources Board (913) 296-3717
Source of Water:
Division of Water Resources Permit #
 Groundwater...Ft North from Southeast Corner (Well) ...Ft West from Southeast Corner of Sec Twp Rge East West
 Surface Water...Ft North from Southeast Corner (Stream, pond etc)...Ft West from Southeast Corner Sec Twp Rge East West
 Other (explain) (purchased from city, R.W.D. #)

INSTRUCTIONS: This form shall be completed in duplicate and filed with the Kansas Corporation Commission, 200 Colorado Derby Building, Wichita, Kansas 67202, within 90 days after completion or recompletion of any well. Rule 82-3-130 and 82-3-107 apply. Information on side two of this form will be held confidential for a period of 12 months if requested in writing and submitted with the form. See rule 82-3-107 for confidentiality in excess of 12 months. One copy of all wireline logs and drillers time log shall be attached with this form. Submit CP-4 form with all plugged wells. Submit CP-111 form with all temporarily abandoned wells.

SIDE TWO

Operator Name R. & C. Drillin, Inc. Lease Name Baalman Well # A-2

Sec. 1 Twp. 11 Rge. 31 East West County Gove

WELL LOG

INSTRUCTIONS: Show important tops and base of formations penetrated. Detail all cores. Report all drill stem tests giving interval tested, time tool open and closed, flowing and shut-in pressures, whether shut-pressure reached static level, hydrostatic pressures, bottom hole temperature, fluid recovery, and flow rate if gas to surface during test. Attach extra sheet if more space is needed. Attach copy of log.

Drill Stem Tests Taken Yes No
 Samples Sent to Geological Survey Yes No
 Cores Taken Yes No

Formation Description
 Log Sample

DST #1 4180-4220 West intermittent blow
 30-3--5 Rec 15' osm, I H 2201 Ff 55-44,
 ISI #54 2nd flow 55-44, FH 2190.
 DST #2 4479-4515, strong blow, 45-45-45-45
 Rec 2440' GSP, 220' OCM IH 2356, 1st flow
 44-55 ISI 571, 2nd flow 88-99, FSI 458,
 FH 2345
 DST #3 4531-4635 West blow dead in 17
 min. 30-30-10 Rec 15' OSM IH 2467 1st
 flow 88-77 ISI 242 2nd flow 88-99 FH 2456

Name	Top	Bottom
Anhydrite	2523	2527
Bs. Anhydrite	2553	2554
Topeka	3706	3758
Heebner	3906	3981
Totonto	3999	4001
Lansing-K.C.	4015	4019
Base D. C.	4288	4290
Pawnee	4420	4425
Fort Scott	4490	4492
Conglomerate Sand	None	None
Mississippi	4746	4647
RTD	4665	
LTD		4663

MAY 21 1986
 WICHITA SURVEY
 WICHITA BRANCH

CASING RECORD <input type="checkbox"/> New <input type="checkbox"/> Used							
Report all strings set-conductor, surface, intermediate, production, etc.							
Purpose of String	Size Hole Drilled	Size Casing Set (in O.D.)	Weight Lbs/Ft.	Setting Depth	Type of Cement	#Sacks Used	Type and Percent Additives
Surface	12 1/4	8 5/8	20	206	60/40poz	145	Quikset
PERFORATION RECORD				Acid, Fracture, Shot, Cement Squeeze Record			
Shots Per Foot	Specify Footage of Each Interval Perforated			(Amount and Kind of Material Used)			Depth
TUBING RECORD				Liner Run <input type="checkbox"/> Yes <input type="checkbox"/> No			
Size	Set At	Packer at					