

COPY

SIDE ONE

1480

STATE CORPORATION COMMISSION OF KANSAS
OIL & GAS CONSERVATION DIVISION
WELL COMPLETION FORM
ACO-1 WELL HISTORY
DESCRIPTION OF WELL AND LEASE

Operator: License # 8541

Name: Petex, Inc

Address: 1610 E. Sunshine

City/State/Zip: Springfield, MO 65804

Purchaser: _____

Operator Contact Person: Larry Childress

Phone (417) 887-1225

Blue Goose Drilling

Contractor: Name: _____

License: 5104

Wellsite Geologist: Tom Funk

Designate Type of Completion

New Well Re-Entry Workover
 Oil SWD Temp. Abd.
 Gas Inj Delayed Comp.
 Dry Other (Core, Water Supply, etc.)

If C. old well info as follows:

Operator: _____

Well Name: _____

Comp. Date 8/24/91 Old Total Depth 9/1/91

Spud Date 8/24/91 Date Reached TD 9/1/91 Completion Date 8/24/91

API NO. 15- 063-21,402

County Gove East

SW NE NW Sec. 5 Twp. 11 Rge. 31 West

4290 Ft. North from Southeast Corner of Section

3630 Ft. West from Southeast Corner of Section
(NOTE: Locate well in section plat below.)

Lease Name Jordon Well # 1

Field Name Dormitory Ext.


Producing Formation _____

Elevation: Ground 3016 KB 3023

Total Depth 4684 PBD _____

RECEIVED

SEP 12 1991

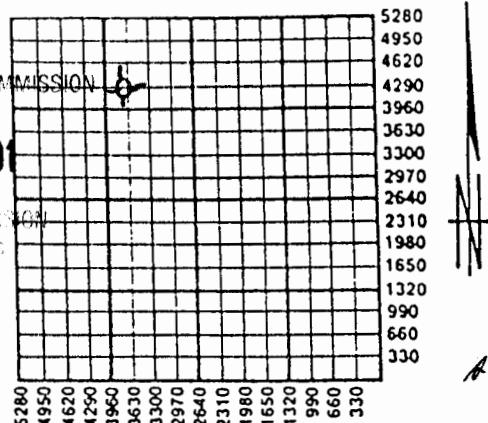

Amount of Surface Pipe Set and Cemented at 295 Feet

Multiple Stage Cementing Collar Used? Yes n/a No

If yes, show depth set _____ Feet

If Alternate II completion, cement circulated from _____

feet depth to _____ w/ _____ sx cmt.

INSTRUCTIONS: This form shall be completed in triplicate and filed with the Kansas Corporation Commission, 200 Colorado Derby Building, Wichita, Kansas 67202, within 120 days of the spud date of any well. Rule 82-3-130, 82-3-107 and 82-3-106 apply. Information on side two of this form will be held confidential for a period of 12 months if requested in writing and submitted with the form. See rule 82-3-107 for confidentiality in excess of 12 months. One copy of all wireline logs and drillers time log shall be attached with this form. ALL CEMENTING TICKETS MUST BE ATTACHED. Submit CP-4 form with all plugged wells. Submit CP-111 form with all temporarily abandoned wells. Any recompletion, workover or conversion of a well requires filing of ACO-2 within 120 days from commencement date of such work.

All requirements of the statutes, rules and regulations promulgated to regulate the oil and gas industry have been fully complied with and the statements herein are complete and correct to the best of my knowledge.

Signature Larry Childress

Title President Date 9/10/91

Subscribed and sworn to before me this 10 day of September,
19 91.

Notarized public Peggy Steelman

Date Commission Expires 7/29/94

K.C.C. OFFICE USE ONLY
 Letter of Confidentiality Attached
 Wireline Log Received
 Drillers Timelog Received

Distribution
 KCC SWD/Rep
 Plug Other
 (Specify) T-5

99415

SIDE TWO

Operator Name Petex, Inc
 Sec. 5 Twp. 11 Rge. 31 East
 West

Lease Name Jordon Well # 1
 County Gove

INSTRUCTIONS: Show important tops and base of formations penetrated. Detail all cores. Report all drill stem tests giving interval tested, time tool open and closed, flowing and shut-in pressures, whether shut-in pressure reached static level, hydrostatic pressures, bottom hole temperature, fluid recovery, and flow rates if gas to surface during test. Attach extra sheet if more space is needed. Attach copy of log.

Drill Stem Tests Taken Yes No
 (Attach Additional Sheets.)

Samples Sent to Geological Survey Yes No

Cores Taken Yes No

Electric Log Run Yes No
 (Submit Copy.)

see attached sheet

Formation Description

Log Sample

Name	Top	Bottom
Anhydrite	2558	+465
B/Anhydrite	2586	+437
Heebner	4026	-1003
Lansing	4065	-1042
Muncie Creek	4202	-1179
Stark	4286	-1263
Marmaton	5379	-1356
Pawnee	4458	-1435
Ft. Scott	4529	-1506
Cherokee SH	4559	-1536

CASING RECORD

Miss

4643

-1620

New Used

Report all strings set-conductor, surface, intermediate, production, etc.

Purpose of String	Size Hole Drilled	Size Casing Set (In O.D.)	Weight Lbs./Ft.	Setting Depth	Type of Cement	# Sacks Used	Type and Percent Additives
surface	12 $\frac{1}{2}$	8-5/8	20	295	60/40poz	165	2%cc 3%gel

PERFORATION RECORD

Acid, Fracture, Shot, Cement Squeeze Record
 (Amount and Kind of Material Used) Depth

Shots Per Foot	Specify Footage of Each Interval Perforated		

TUBING RECORD	Size	Set At	Packer At	Liner Run	<input type="checkbox"/> Yes <input type="checkbox"/> No

Date of First Production	Producing Method	<input type="checkbox"/> Flowing	<input type="checkbox"/> Pumping	<input type="checkbox"/> Gas Lift	<input type="checkbox"/> Other (Explain)
Estimated Production Per 24 Hours	Oil Bbls.	Gas Mcf	Water Bbls.	Gas-Oil Ratio	Gravity

Disposition of Gas:

METHOD OF COMPLETION

Production Interval

Vented Sold Used on Lease
 (If vented, submit ACO-18.) Open Hole Perforation Dually Completed Commingled
 Other (Specify) _____

COPY
DRILL STEM TESTS

5-11-31W

No.	Interval	IFP/Time	ISIP/Time	FFP/Time	FSIP/Time	IHH-FHH	RECOVERY
1	4250- 4277	55-55 30"	225# 30"	55-55 30"	60# 30"	2089- 2055# 116°F.	60' mud
2	4440'- 4470	44-44 30"	225# 30"	44-44 30"	120# 30"	2240- 2190# 120°F.	60' GIP 60' SO ₂ cm (290g, 5300)
3	4478- 4570	32-22 30"	44# 30"	22-22 30"	32# 30"	2270- 2220# 121°F.	10' OSM
4	4551- 4650	33-33 30"	309# 30"	33-33 30"	215# 30"	2290- 2260# 122°F.	30' mud

RECEIVED
 STATE CORPORATION COMMISSION

SEP 12 1991

CONSERVATION DIVISION
 Wichita Falls