

Pi

STATE CORPORATION COMMISSION OF KANSAS  
OIL & GAS CONSERVATION DIVISION

WELL COMPLETION OR RECOMPLETION FORM  
ACO-1 WELL HISTORY

DESCRIPTION OF WELL AND LEASE

Operator: license # 5198  
name A. Scott Ritchie  
address 125 N. Market  
Suite 950  
City/State/Zip Wichita, KS 67202

Operator Contact Person Rocky Milford  
Phone (316) 267-4375

Contractor: license # 6033  
name Murfin Drilling Co.

Wellsite Geologist Larry Zink  
Phone (316) 267-4375

PURCHASER none

Drill Date Type of Completion  
 New Well  Re-Entry  Workover

- Oil  SWD  Temp Abd
- Gas  Inj  Delayed Comp.
- Dry  Other (Core, Water Supply etc.)

If ~~NO~~ old well info as follows:  
Operator  
Well Name  
Comp. Date Old Total Depth

JUL 0 2 1985

State Geological Survey  
WICHITA BRANCH

WELL HISTORY

Drilling Method:  Mud Rotary  Air Rotary  Cable  
4/12/85 4/21/85 4/21/85  
Sp. Date Date Reached TD Completion Date

4648' RTD n/a  
Total Depth PBDT

Amount of Surface Pipe Set and Cemented at 302' feet

Multiple Stage Cementing Collar Used?  Yes  No

If Yes, Show Depth Set feet

If alternate 2 completion, cement circulated  
from 302 feet depth to surface w/ 190 SX cmt

Wireline Log Rec'd

API NO. 15 - 063-20,897

County Gove

C S/2 SW NE Sec 15 Twp 11S Rge 31 East West

2970 Ft North from Southeast Corner of Section  
1980 Ft West from Southeast Corner of Section  
(Note: locate well in section plat below)


Lease Name Tatum Well# 1

Field Name Unknown

Producing Formation none

Elevation: Ground 2989' KB 2994'

Section Plat

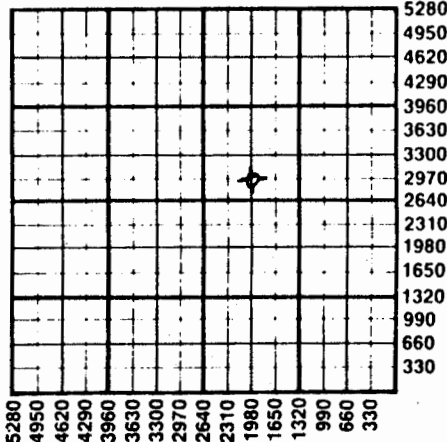

WATER SUPPLY INFORMATION

Source of Water:  
Division of Water Resources Permit #

Groundwater. Ft North From Southeast Corner and  
(Well) Ft West From Southeast Corner of  
Sec Twp Rge East West

Surface Water. Ft North From Southeast Corner and  
(Stream, Pond etc.) Ft West From Southeast Corner  
Sec Twp Rge East West

Other (explain) (purchased from city, R.W.D.#)

Disposition of Produced Water:  Disposal  Repressuring

Docket #

INSTRUCTIONS: This form shall be completed in duplicate and filed with the Kansas Corporation Commission, 200 Colorado Derby Building, Wichita, Kansas 67202, within 90 days after completion or recompletion of any well. Rules 82-3-130 and 82-3-107 apply.

Information on side two of this form will be held confidential for a period of 12 months if requested in writing and submitted with the form. See rule 82-3-107 for confidentiality in excess of 12 months.

One copy of all wireline logs and drillers time log shall be attached with this form. Submit CP-4 form with all plugged wells. Submit CP-111 form with all temporarily abandoned wells.

