

**IMPORTANT**  
Kans. Geo. Survey request samples on this well.

15-109-20130

API No. 15 — 109 — 20,130  
County Number

S. 1 T. 11 R. 32 W  
Loc. SE SE  
County Logan

Operator  
Ostmeyer & Senior

Address  
P. O. Box 852 Colby, Kansas 67701


Well No. # 1 Lease Name Steinle

Footage Location  
660' feet from (N) 257 line 660' feet from (W) line

Principal Contractor Western Well & Pump Geologist L. Chubb

Spud Date 5/3/79 Total Depth 1091' P.B.T.D.

Date Completed 5/11/79 Oil Purchaser

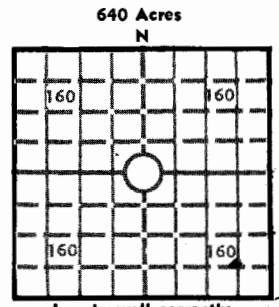

Elev.: Gr. 3035  
DF \_\_\_\_\_ KB \_\_\_\_\_

**CASING RECORD**

Report of all strings set — surface, intermediate, production, etc.

Purpose of string	Size hole drilled	Size casing set (in O.D.)	Weight lbs/ft.	Setting depth	Type cement	Sacks	Type and percent additives
Surface	9 7/8	6 5/8	.188wall	327	60/40	100	2% Cal- 6% Gel

**LINER RECORD**

**PERFORATION RECORD**

Top, ft.	Bottom, ft.	Sacks cement	Shots per ft.	Size & type	Depth interval

**TUBING RECORD**

Size	Setting depth	Packer set at

**ACID, FRACTURE, SHOT, CEMENT SQUEEZE RECORD**

Amount and kind of material used	Depth interval treated

**INITIAL PRODUCTION**

Date of first production		Producing method (flowing, pumping, gas lift, etc.)			
RATE OF PRODUCTION PER 24 HOURS		Oil	Gas	Water	Gas-oil ratio
		bbls.	MCF	bbls.	CFPB
Disposition of gas (vented, used on lease or sold)				Producing interval(s)	

INSTRUCTIONS: As provided in KCC Rule 82-2-125, within 90 days after completion of a well, one completed copy of this Drillers Log shall be transmitted to the State Geological Survey of Kansas, 4150 Monroe Street, Wichita, Kansas 67209. Copies of this form are available from the Conservation Division, State Corporation Commission, 3830 So. Meridian (P.O. Box 17027), Wichita, Kansas 66217. Phone AC 316-522-2206. If confidential custody is desired, please note Rule 82-2-125. Drillers Logs will be on open file in the Oil and Gas Division, State Geological Survey of Kansas, Lawrence, Kansas 66044.

Operator DSTINEYER & SENIOR DESIGNATE TYPE OF COMP.: OIL, GAS, DRY HOLE, SWDW, ETC.:

Well No. A1 Lease Name STEINLE

S 1 T 11 R 32 W

**WELL LOG**

Show all important zones of porosity and contents thereof; cored intervals, and all drill-stem tests, including depth interval tested, cushion used, time tool open, flowing and shut-in pressures, and recoveries.

SHOW GEOLOGICAL MARKERS, LOGS RUN, OR OTHER DESCRIPTIVE INFORMATION.

FORMATION DESCRIPTION, CONTENTS, ETC.	TOP	BOTTOM	NAME	DEPTH
Clay	0	40		
Fine to coarse sand	40	120		
Coarse sand	120	170		
Clay	170	173		
Coarse sand	173	188		
Shale, streaks of hard formation, sandstone	188	1090		

USE ADDITIONAL SHEETS, IF NECESSARY, TO COMPLETE WELL RECORD.

Date Received \_\_\_\_\_

Signature Roy E. Senior Jr.

Title PRESIDENT

Date 6-11-79

100535

